



FORM F-106



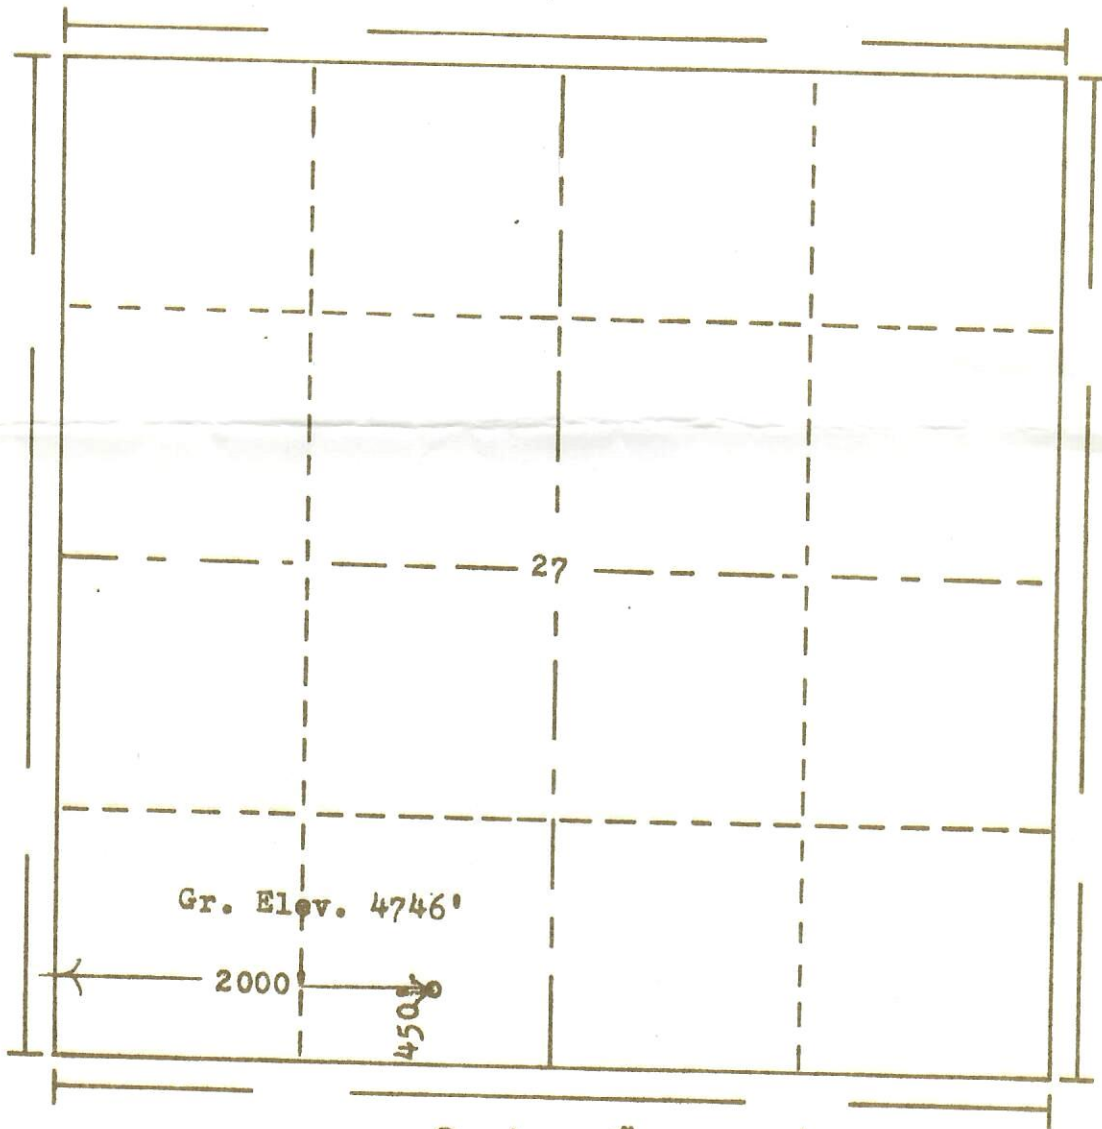
00197443

RECEIVED

JUN 20 1974

GOLD, OIL & GAS CONS. COMM.

R. 67W

T.
6
N

Scale... 1" = 1000'

Powers Elevation Company, Inc. of Denver, Colorado
has in accordance with a request from Mr. Colton
for Colton & Colton et al
determined the location of No.1 Kodak
to be 450'FS & 2000'FW
Range 67W of the 6th Principal Meridian
Section 27 Township 6N
Weld County, Colorado

~~CONFIDENTIAL~~

I hereby certify that this plat is an
accurate representation of a correct
survey showing the location of

74 614
Date: 6-6-74

R. J. Hollaway
Licensed Land Surveyor No. 2853
State of Colorado