


Hamlin #1 Existing WBD



DESCRIPTION DEPTH WELLBORE

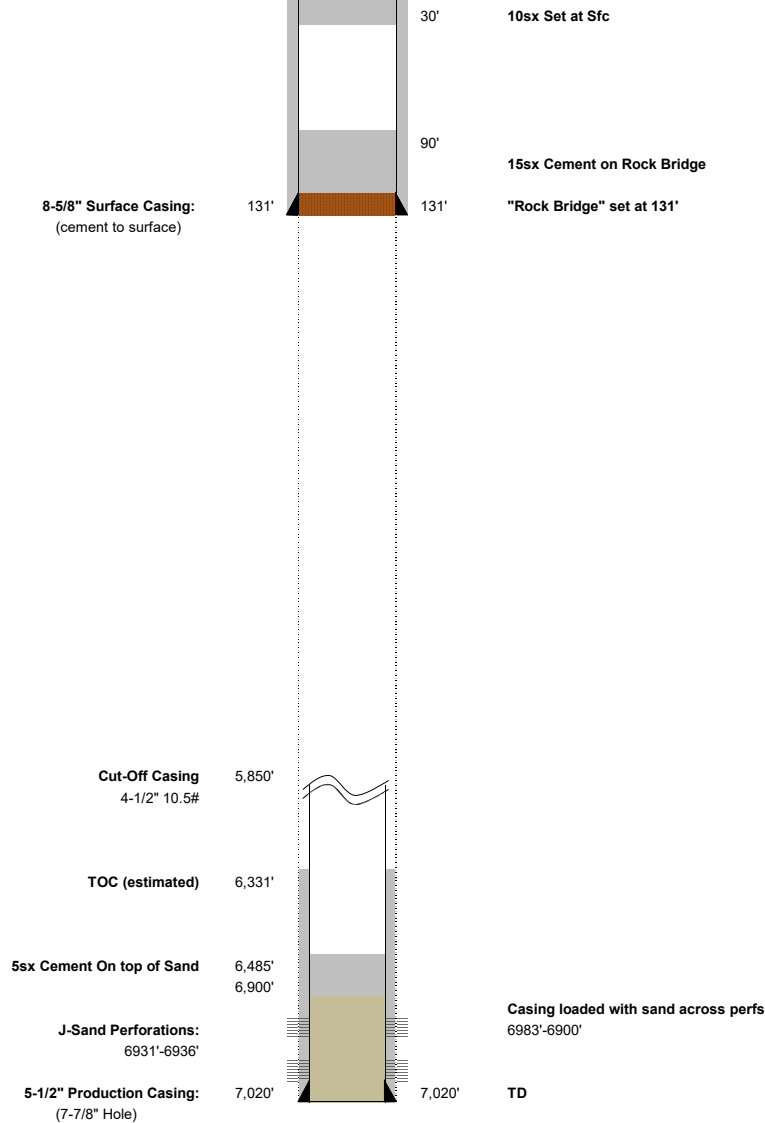

WELL: Hamlin #1

LOCATION: NENE 2 9N 59W
660 FNL 660FEL (Planned)
40.785344°N, -103.938669°E

FORMATION: JSND 6/21/1974

API #: 05-123-07506

Field: IGO Creek

CURRENT STATUS: DA

Spud: 7/23/1972
P&A: 6/21/1974

| Type | Size | Weight | Top | Bottom | Hole Size |
|------------|--------|----------|-----|--------|-----------|
| Surface | 8-5/8" | 20 ppf | 0 | 131' | 12-1/4" |
| Production | 4-1/2" | 10.5 ppf | 0 | 7,020' | 7-7/8" |

| Elevation Data | | |
|----------------|------|------|
| GL | 5030 | feet |
| KB | 5039 | feet |
| Difference | 9 | feet |

| Formation Tops Data | | |
|----------------------|-------|----|
| Formation | Depth | |
| Base of Fox Hills | 524' | MD |
| Base of Upper Pierre | 1542' | MD |
| Sussex | 4083 | MD |
| Niobrara | 5960' | MD |
| D Sand | 6752' | MD |
| J Sand | 6842' | MD |