


Wayne L. Wise

Alice Welp 1-10
SWSW S10-T1S-R45W Yuma County CO
05-125-06888

CURRENT WELLBORE-PR
May 10 2023

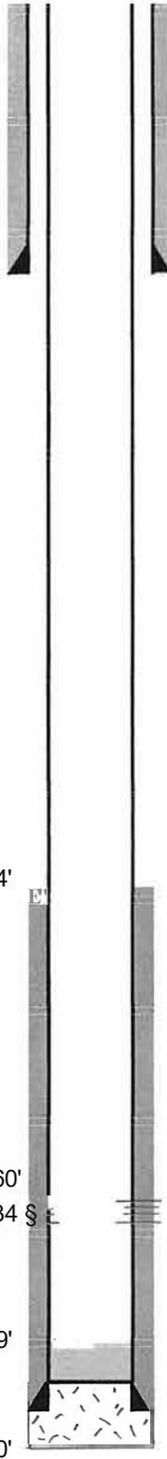

Surface casing hole, 9.875"

7" 23# Surface casing@ 406'. Cemented with 100 sacks cement. Cement circulated.

Reported TOC 1,574'

Production casing hole, 6.25"

Top of Niobrara 2,260'

Perforations: 2,298-2,334'

PBD 2,369'

TD 2,500'

4.5" 9.5# Production casing @2,410'. Cemented with 100 sacks 50/50 Pozmix w/2% Gel