

CERTIFICATE OF SURVEY
for
Colton and Colton
Weld County, Colorado




00219526

RECEIVED

JAN 6 1976

COLORADO OIL & GAS COM. COMM.

T6N R67W 6PM
FROM KODAK BOUNDARY SURVEY MONUMENTS

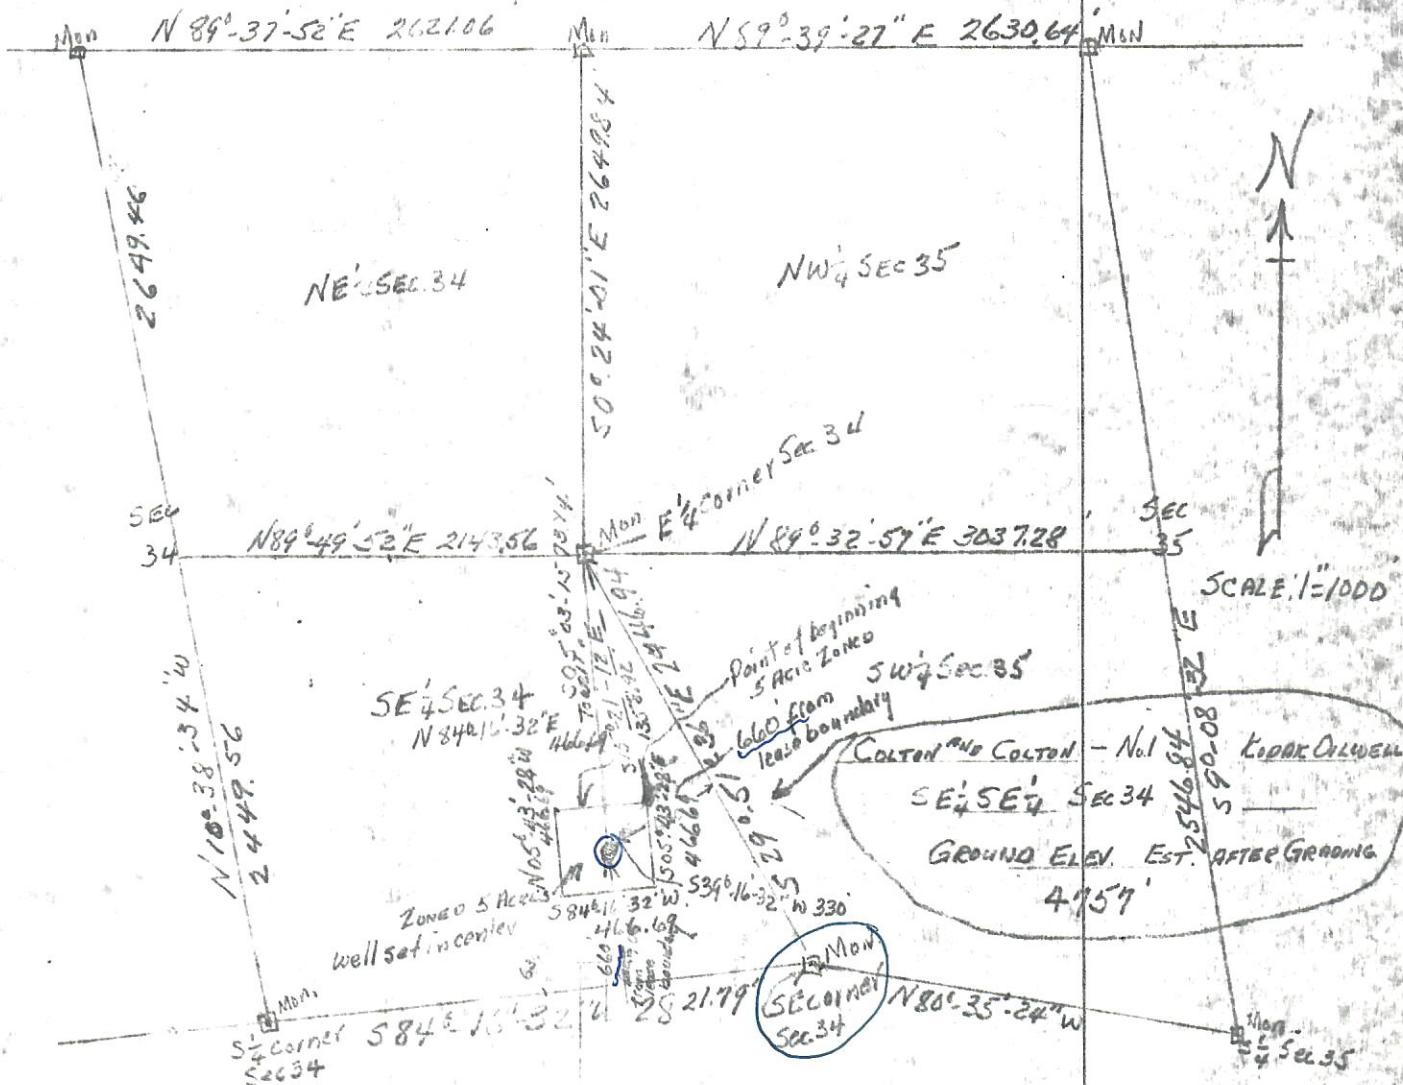

I hereby certify that the above plat is a correct representation of the location of Colton and Colton No. 1 Kodak Oilwell in SE 1/4 Sec. 34 T6N R67W 6PM from the monuments of the boundary survey of the Kodak Property and a map showing the zoning change of 5 acres in which the location is made. The elevation of the ground is estimated after grading to be 4757 feet above sea level from the Bench mark at the E 1/4 corner of Sec. 34 set by Kodak.

Fort Morgan, Colorado
Dec. 30, 1975

Leah J. Osborne
Registered Professional Engineer
State of Colorado

file