

STATE OF COLORADO
DIVISION OF WATER RESOURCES
OFFICE OF THE STATE ENGINEER
GROUND WATER SECTION

RECORDED

NOV 19 1959
GROUND WATER SECT.
COLORADO
STATE ENGINEER

Index No. 613
IDWD 1-1
Use Domestic
Registered 11/13/59
Cards Typed NOV-24-1959

LOG AND HISTORY OF WELL
PERMIT NO. 4212
Lic.

Drilled by Gummins Well Works No. 73

Owner Clifford Aronson

Address Rt 1, Box 187, Greeley, Colo.

Tenant _____

Used for Domestic

on or by SW $\frac{1}{4}$, SW $\frac{1}{4}$, Sec 18, T 6N, Rge 64W
(description of site or land)

Date Started August 27, 1959

Date Completed August 27, 1959

Date Tested August 28, 1959

Yield 14 \checkmark gpm _____ cfs

Pump type Jet Outlet Size 3/4

Driven by 1/2 HP @ RPM 3400

Depth to Water 11 Ft. Draw down 16 Ft.

Depth to Inlet 19 Ft.; Bowl Foot valve

Size and Kind of Casing:

From 0 to 20 Type 6" Stan Wt. 10 lbs

From _____ to _____ Type _____ Wt. _____

From _____ to _____ Type _____ Wt. _____

Perforations: Size and Type

From 8 to 20 Type slot Size 1/8"

From _____ to _____ Type _____ Size _____

From _____ to _____ Type _____ Size _____

Well description: Total Depth 20' Ft.

Hole (from 0 to 20 ft. 10 in.

Diam. (from _____ to _____, _____ in.

(from _____ to _____, _____ in.


WELL LOCATION

Weld 62 County

SW $\frac{1}{4}$ of SW $\frac{1}{4}$ of Sect. 18

Twp. 6 N, Rge. 64W, 5 PM

LOCATE WELL ACCURATELY
IN THE SMALL SQUARES REP-
PRESENTING 40 ACRES

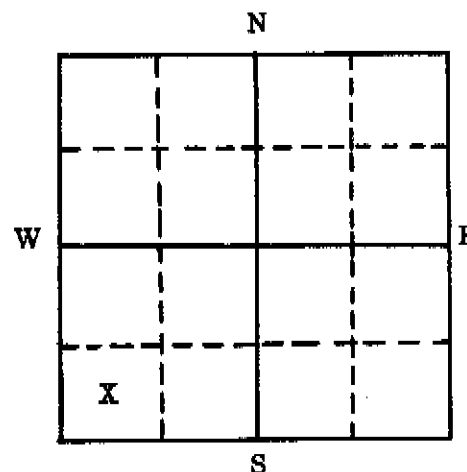

If the above is not applicable
fill in:

Town or Subdivision _____

Street Address or Lot & Block _____

Ground elevation _____
(if known)

How Drilled:

Rotary

REMARKS

Cementing, Packing, Type of
Shut-off, Depth to Shut-off, etc.
PUT LOG OF WELL ON RE-
VERSE SIDE

TO BE MADE OUT IN QUADRUPLICATE: Original Blue and Duplicate Green to
State Engineer's Office, White copy to Owner, and Yellow copy to Driller

LOG OF WELL
(ADD SPACES AS NEEDED)

From 0 ft. to 3 ft. Top soil

3 ft. to 6 ft. Clay

6 ft. to 8 ft. Gravel.

8 ft. to 21 ft. Clay

 ft. to ft.

Form C(Rev.)
7-58/5M

STATE OF COLORADO
APPLICATION FOR USE OF GROUND WATER
(Use Indelible Pencil or Typewriter)

Applicant Clifford Aronson

P.O. Address Gill, Colorado

Quantity applied for 6 gpm or
AF Storage

Used for Domestic Purposes

on/at SW $\frac{1}{4}$, SW $\frac{1}{4}$, Sec 18, T 6N, R 64W
(legal description of land site)

Total acreage irrigated and other rts.

ESTIMATED DATA OF WELL

Hole size: 10 in. to 40 ft.
in. to ft.

Casing Plain 5 in. from 0 to 22 ft.
in. from to ft.

Perf. 5 in. from 22 to 40 ft.
in. from to ft.

PUMP Outlet

DATA: Type Jet . HR/2 . Size

Use initiation date August 1959
(Use Supplemental pages for additional data)

THIS APPLICATION APPROVED

NO. 4212

DATE AUG 24 1959 19

LOCATION OF WELL


County Weld

SW $\frac{1}{4}$, SW $\frac{1}{4}$ Sect. 18, Twp. 6 N.

Rge. 64W, 6 P.M. OR

Street Address or Lot & Block No.

Town or Subdivision

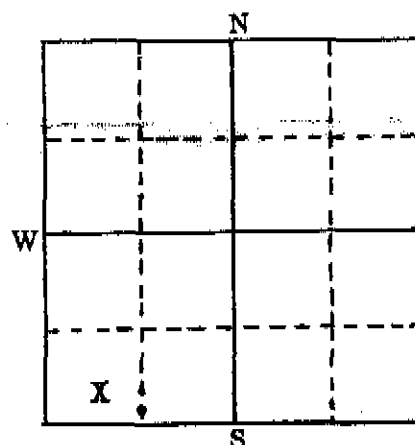

Locate
well in
40 acre
(small)
square
as near
as possible.

\$25.00 fee required for Industrial,
Commercial or Irrigation uses.

Applicant Clifford Aronson

Agent or
Driller Cummins Well Works No. 73

Address 121-13th St. Greeley, Colo.

NOTE — SATISFACTORY COMPLETION REQUIRED FOR APPROVAL OF APPLICATION