

Legend

- Underground Flowline Location
(Collected via Trimble GPS)
- Laboratory Sample Location
(Collected via Trimble GPS)

Notes

All locations are approximate unless otherwise noted.

GPS – Global Positioning System

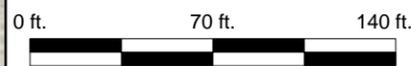


Image Source: Google Earth; June 2021
Projection: WGS 84 UTM Zone 13 North

DATE: March 15, 2023

DESIGNED BY: C. Hamlin

DRAWN BY: E. Wozniak



Tasman, Inc.
6855 W. 119th Ave.
Broomfield, CO 80020

PDC Energy, Inc. – DJ Basin
Former Dinner 4-8-14 Wellhead
NESE, Section 14, Township 4 North, Range 66 West
Weld County, Colorado

SOIL SAMPLE
LOCATION MAP
(FLOWLINE)

FIGURE
2