



**Legend**

-  Excavation Extent  
(Collected via Trimble GPS)
-  Underground Flowline Location  
(Collected via Trimble GPS)
-  Laboratory Sample Location  
(Collected via Trimble GPS)
-  Field Screening Sample Location  
(Collected via Trimble GPS)

**Notes**

All locations are approximate unless otherwise noted.

GPS – Global Positioning System

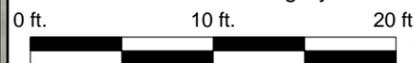


Image Source: Google Earth; June 2021  
Projection: WGS 84 UTM Zone 13 North

DATE: March 14, 2023

DESIGNED BY: C. Hamlin

DRAWN BY: E. Wozniak



**Tasman, Inc.**  
6855 W. 119<sup>th</sup> Ave.  
Broomfield, CO 80020

**PDC Energy, Inc. – DJ Basin**  
**Former Dinner 4-8-14 Wellhead**  
NESE, Section 14, Township 4 North, Range 66 West  
Weld County, Colorado

SOIL SAMPLE  
LOCATION MAP

FIGURE  
1