


D&B Ventures Ferguson #1 Bond Claim: Task 2 - Plug and Abandon - 385297 067-05236
Ferguson #1

Prepared	8/15/2022	<u>Notes:</u> Spud 08/11/1962 Deepest water well within 1 mile is 360' Perform Soil Gas Survey Re-enter and replug if necessary
FIELD NAME	Red Mesa	
FIELD NUMBER	72890	
<u>LOCATION</u>		
Basin	San Juan	Mineral Owner: Fee
Location-Townships	33N	Surface Owner: Fee
Location-Ranges	12W	
Elevation	6,499'	

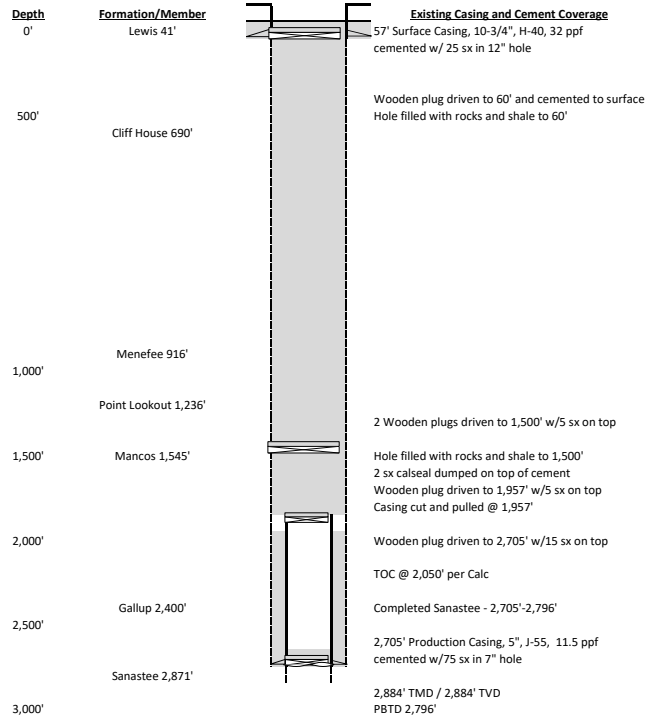

*BOP or other mechanical method should be used for well control

