




P&A Wellbore For State

Well Name: Wilson Creek 38

Land, Original Hole, 6/27/2023 12:02:38 PM

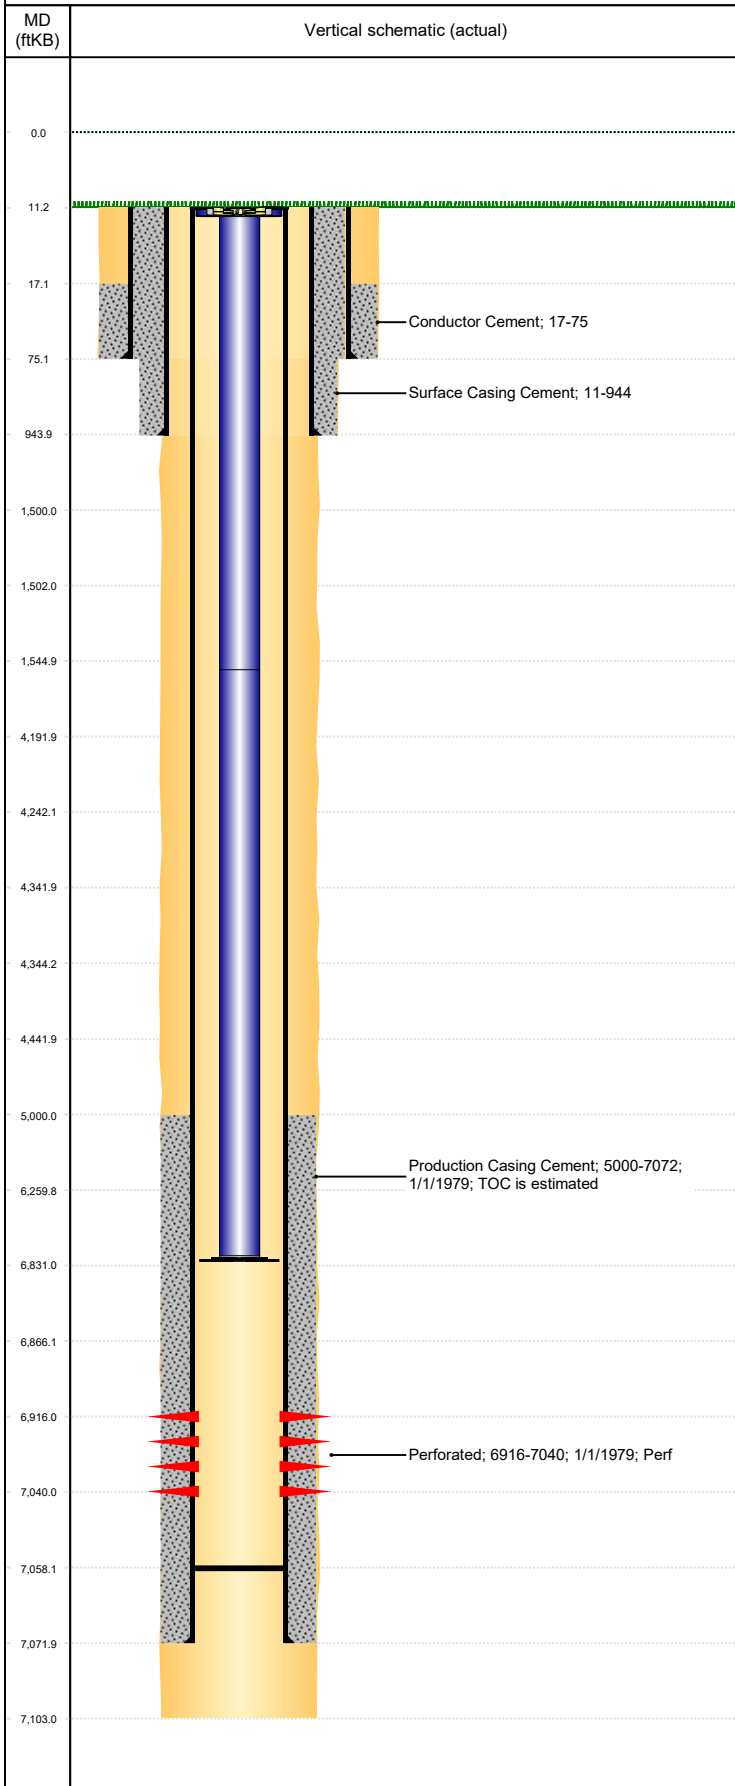

Well Header							
Surface UWI 0510305841		Business Unit Rockies		Gov Auth Dist		Prod Tree Loc Land	
Orig. KB to Gnd (ft) 11.00	Original Spud Date 7/24/1953	Abandon Date		Well Sub-Status		High... N	
Comment							
Wellbore Sections							
Section Des		Hole Size (in)		Act Top (ftKB)		Act Btm (ftKB)	
Pilot Hole		20		11.0		75.0	
Surface		14		75.0		944.0	
Production		11		944.0		7,103.0	
Casing Strings							
Csg Des		Run Date	OD (in)	Wt/Len (lb/ft)	Grade	Top Depth (MD) (ftKB)	Set Depth (MD) (ftKB)
Conductor			16	70.00	H-40	11	75
Surface			10 3/4	40.50	H-40	11	944
Production Casing		1/1/1979	7	23.00	N-80	11	7072
Cement							
Des			Start Date		Top (ftKB)		Btm (ftKB)
Conductor Cement					17.0		75.0
Surface Casing Cement					11.0		944.0
Production Casing Cement					5,000.0		7,072.0
Zone Statuses							
Zone Name	Status Date	Status	Fluid Type	Job			Prod Method
Perforation Data							
Linked Zone		Explosive Type	Entered Shot Total	Top (ftKB)		Btm (ftKB)	Date
Morrison, Original Hole				6,916.0		7,040.0	1/1/1979
Other In Hole							
Run Date	Des			Make	OD (in)	Top (ftKB)	Btm (ftKB)
Logs							
Date	Type				Depth Top (MD) (ftKB)		Btm (ftKB)
Plug Back Total Depths							
Date	Type	Com					PBTD (ftKB)
11/4/2008							7,058