


WELL NAME: STATE ANTELOPE W-C-3HN OPERATOR: BONANZA CREEK ENERGY OPERATING COMPANY not to scale
 FIELD: WATTENBERG FORMATION: Niobrara GROUND LEVEL: 4646
 SHL: qtr-qtr SWNW Section 2 Township 5N Range 62W KELLY BUSHING: 4671
 BHL: qtr-qtr NWSW Section 3 Township 5N Range 62W SPUD DATE: 9/2/2022
 COUNTY: WELD STATE: CO API: 05-123-51726-00 TD DATE: 11/4/2022

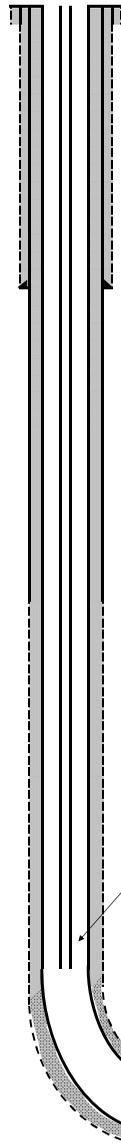

CONDUCTOR CASING
 SIZE: 16
 WEIGHT: 52#
 HOLE SIZE: 26
 CSG DEPTH: 124

SURFACE CASING
 SIZE: 9-5/8"
 WEIGHT: 36#
 HOLE SIZE: 13-1/2"
 HOLE DEPTH: 1,636
 CSG DEPTH: 1,636
 CEMENT: 659 SKS
 TOC: SURFACE

PRODUCTION CASING
 SIZE: 5-1/2"
 WEIGHT: 20#
 HOLE SIZE: 8-1/2"
 TOTAL DEPTH TVD: 6,279
 TOTAL DEPTH MD: 11,351
 CSG DEPTH: 11,347
 CEMENT: 1840 SKS
 TOC: SURFACE

PRODUCTION TUBING
 SIZE: 2 3/8"
 WEIGHT: 4.7#
 DEPTH: 6,287
 PACKER DEPTH: 6,284

FRAC DATA

254,669	BBLS GELLED FLUID
321	BBLS ACID
5,766	BBLS FRESH WATER
260,756	BBLS TOTAL FLUID

FORMATION TOPS & PERFORATIONS

NIORARA MD	6,339	
PERFORATIONS	6,683	11,284

0	# 30/50 MESH
4,313,005	# 40/70 MESH
3,188,060	# 100 MESH
7,501,065	# TOTAL SAND
25	STAGES

25 24 23 22 21 20 19 18 17 16 15 14 13 12 11 10 9 8 7 6 5 4 3 2 1