




CERTIFICATE OF SURVEY
for
Midwest Oil Corp.
Logan County, Colorado

RECEIVED
JAN 18 1965

OIL & GAS
CONSERVATION COMMISSION

T7N R54W 6PM

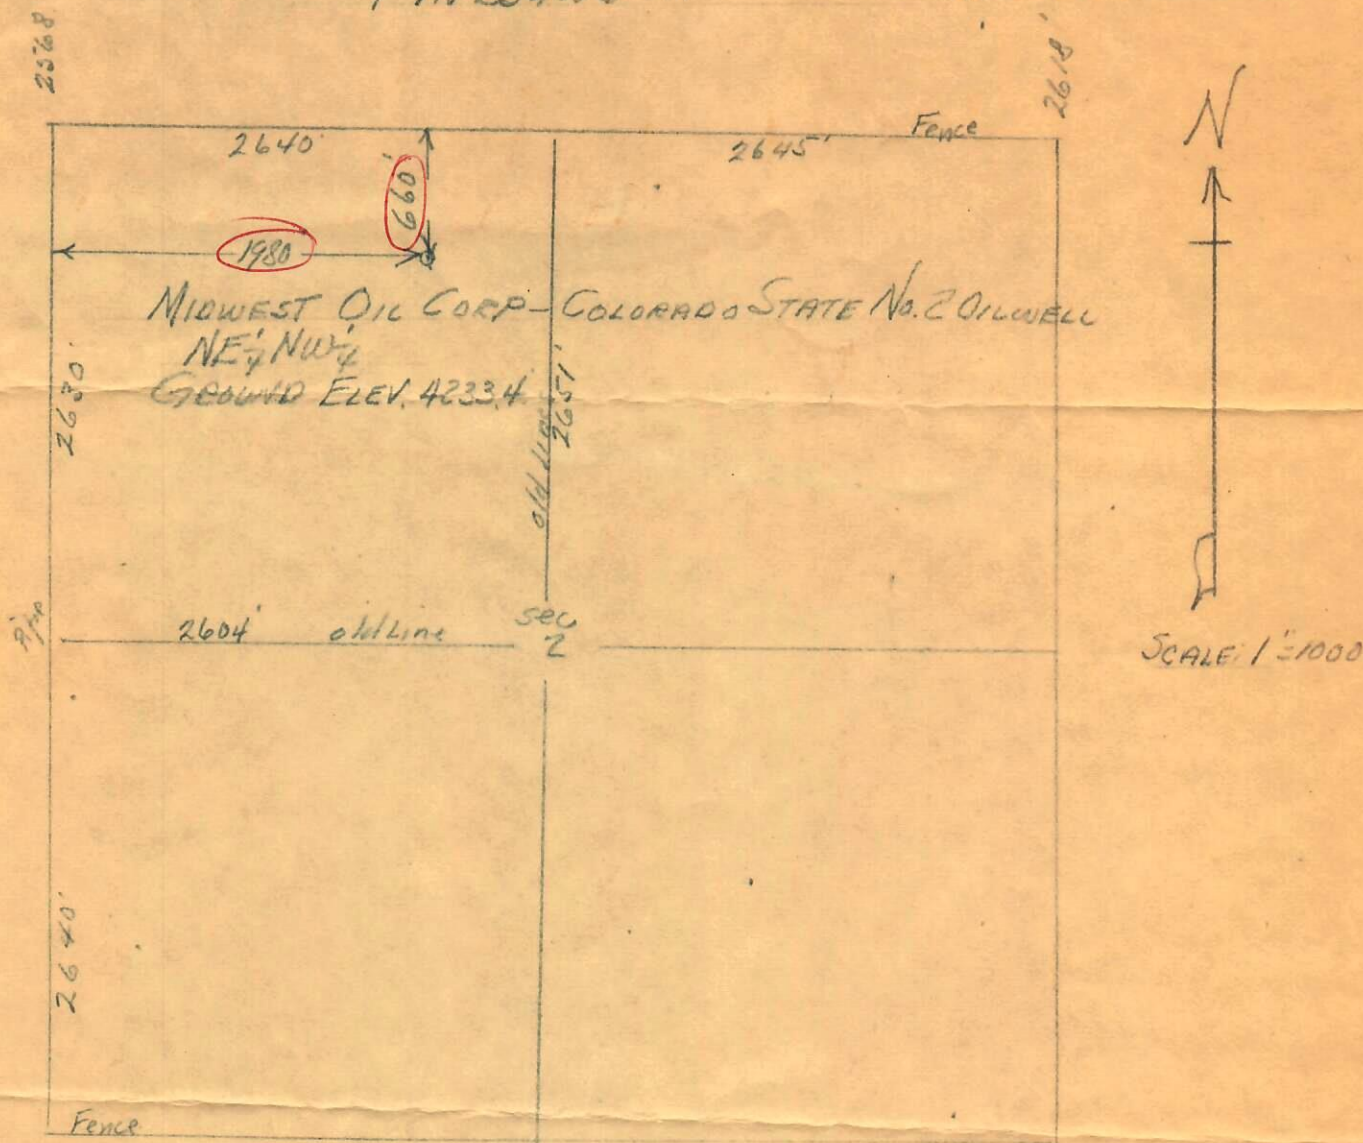

I hereby certify that the above plat is an accurate representation of a correct survey showing the location of Midwest Oil Corp. - Colorado State No. 2 Oilwell in NE 1/4 NW 1/4 Sec. 2 T7N R54W 6PM. The elevation of the ground at the stake is 4233.4 feet above sea level from U.S.C.&G. Bench Mark.

Fort Morgan, Colorado
Jan. 11, 1965

Bevil Osborne
Registered Professional Engineer
State of Colorado

65-9