

OIL AND GAS CONSERVATION COMMISSION OF THE STATE OF COLORADO

RECEIVED FEB 25 1963 OIL & GAS CONSERVATION COMMISSION

39 X

NOTICE OF INTENTION TO DRILL



00622019


INSTRUCTIONS:

A notice of intention to drill a well shall be filed in duplicate on all Federal and Patented lands, and in triplicate on all State lands. Do not begin operations until approved copy has been received. It is mandatory that the proposed location comply with all rules and regulations of the Commission. Locate well on section grid in proper location, and indicate extent of lease. Unless operations are commenced within 180 days after the date of approval hereof, this approval to drill will become null and void.

Name of Operator Greeley Real Estate and Development Co. Phone No. Address Box 414 City Greeley State Colorado

How is liability secured: Well Bond (Attached) Blanket Bond Waiver (Check one)

Lease Name Hamil Well No. 2 Field Name Wildcat County Logan

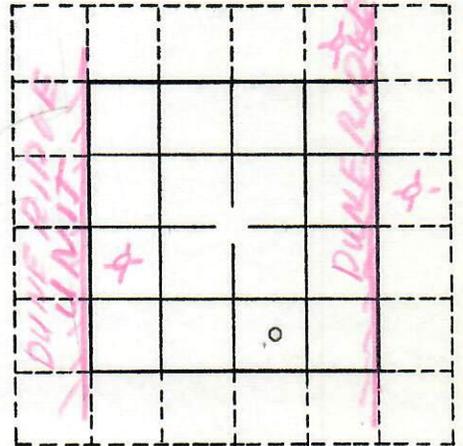

OK OK difference from verbal

Location C SW SE Section 33 Township 7N Range 52W Meridian 6 P.M. 660 feet from South Section line and 1980 feet from East Section Line N or S E or W

The well is located on: Patented land State land Federal land

The well is located within a spaced area: Yes No Dune Ridge Causeway 54' 10' set 40' Tol 100'

Distance from proposed location to nearest property or lease line 660 feet. Distance from proposed location to nearest drilling unit line feet.

Objectives: "J" Formation Depth 4500 Estimate; "D" Formation Depth 4400 Estimate

Proposed length of surface casing 140 feet.

REMARKS:

Table with columns for Agent, Bond, Spot, Wells, Oil, Gas, Status. Includes handwritten notes like '600 ft already drilled' and '9 ppg'.

I/We hereby swear (or affirm) that the statements herein made are a full and correct report.

APPROVED: Date FEB 25 1963 Company Greeley Real Estate Development Date 2-21-63 Address Box 414 Phone No Am 6-9651 By CW Hughes Signature Title Consult Geol Director

REMARKS: Drilled without approval

VIOLATION