




R. 53 W.

RECEIVED

FEB 27 1967

COLO. OIL & GAS CONS. COMM.

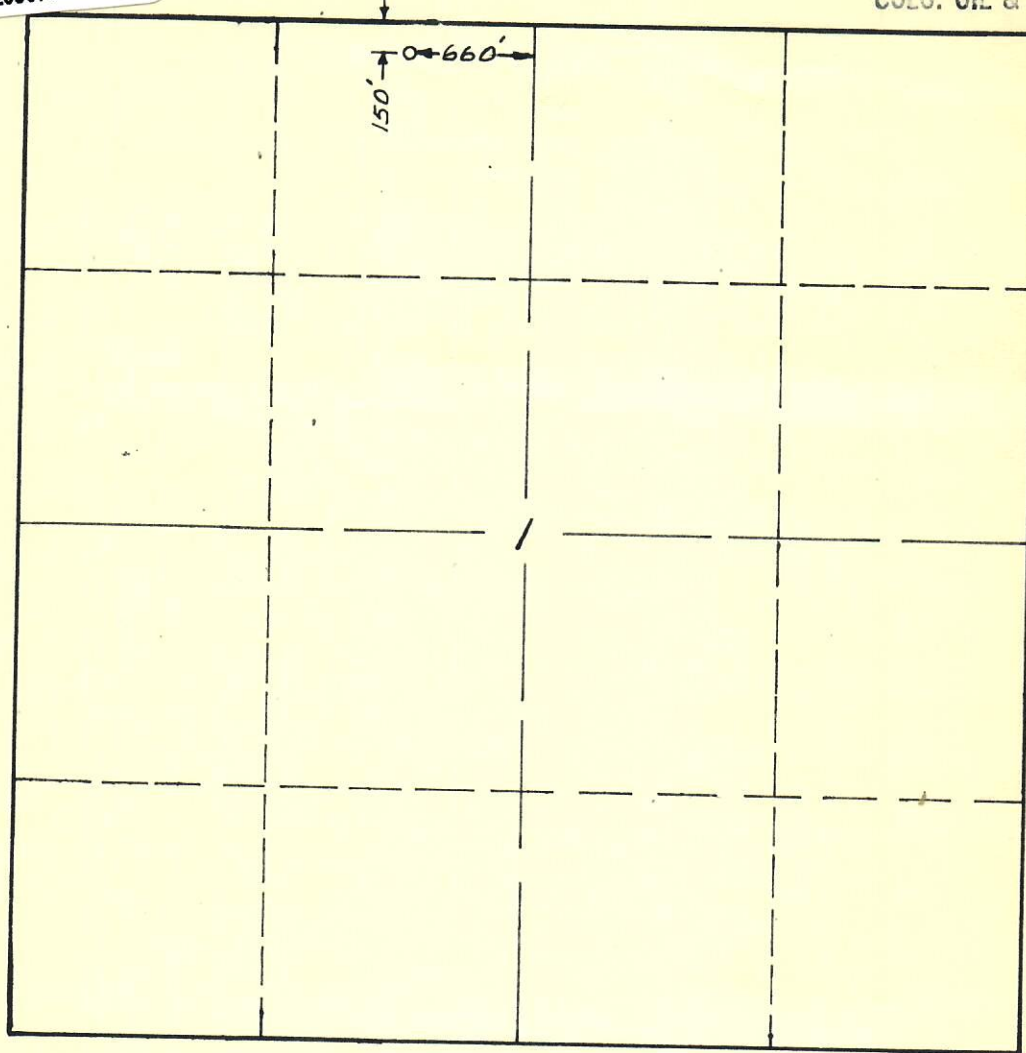

T.  
7  
N.

Scale: 1"=1000"

This is to certify that this is a true and correct survey and plat  
of Frank H. Walsh No. 1 A. J. Fritzler  
drilling site, located 150' FN & 660' FE NW $\frac{1}{4}$  Section 1 , Town-  
ship 7 North , Range 53 West, Sixth Principal Meridian,  
Logan County, Colorado ; being more particu-  
larly described as follows: beginning at the North  $\frac{1}{4}$  corner  
of said Section 1 ; thence South 150 feet; thence  
West 660 feet, to said drilling site.

Ground Elevation— 3979.7 Feet

Requested By: Frank H. Walsh

Date Staked: February 8, 1967

By:

*Burr Leibert*

Burr Leibert

Registered Land Surveyor  
Colorado No. 1791

