




RECEIVED

AUG 09 1983

R. 67 W.

COLO. OIL &amp; GAS CONS. COMM.

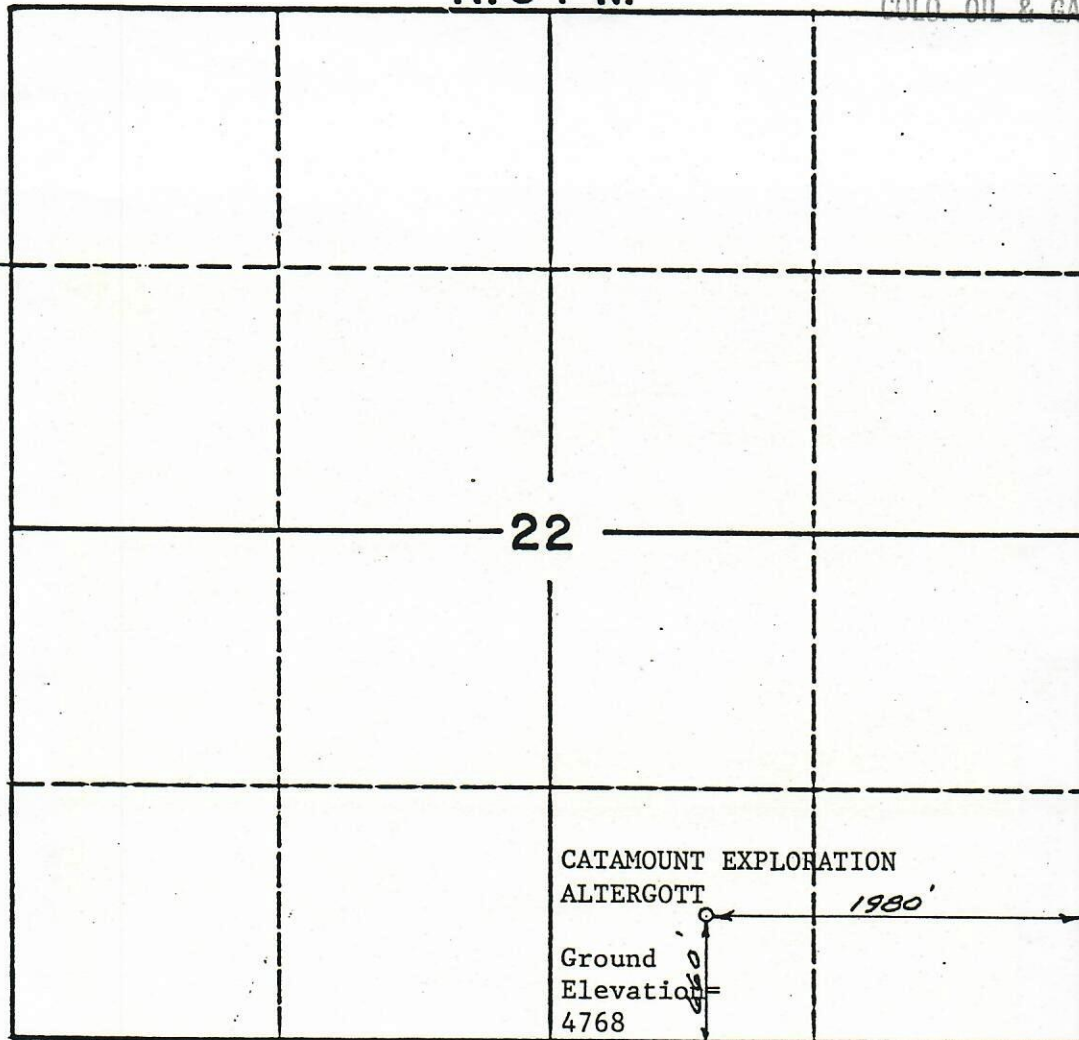

SCALE: 1"=1000'

Flatirons Surveying, in accordance with a request from Catamount Exploration, has determined the location of ALTERGOTT to be 1980' more or less FEL, and 660' more or less FSL of Section 22, T.6N., R.67W., 6th. Principal Meridian, Weld County, Colorado.



Aug. 9, 1983  
#83-706



Flatirons Surveying  
855 Broadway, Ste. 4  
Boulder, CO 80302

Altergott - 275 psi on  
surface - says  
Steve Pott 1/19/89

Gas reported for Mar 85

3/13/84 per  
phone call -  
well still not  
hooked up to  
PL Hm