



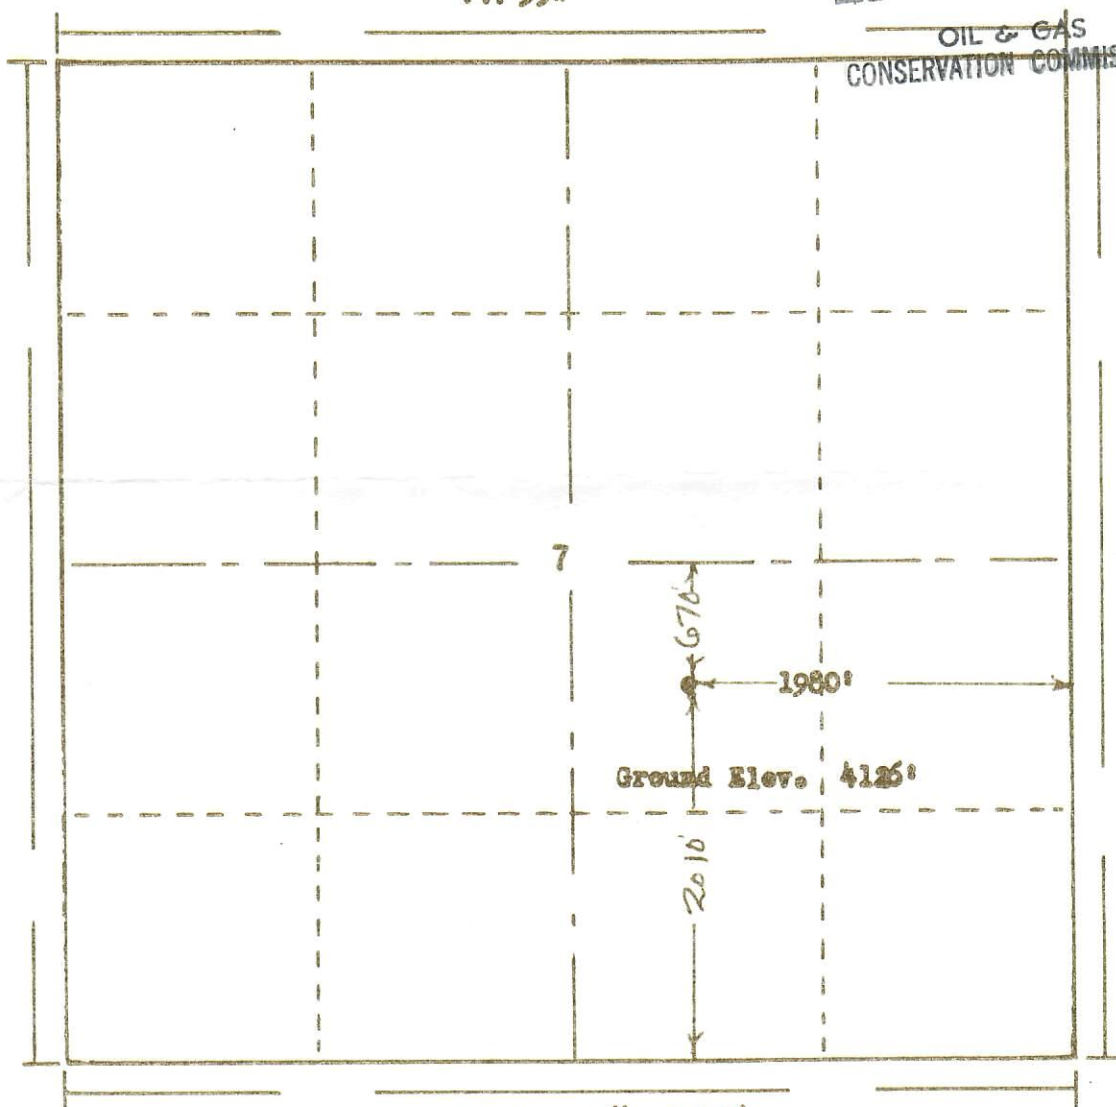
99999999

075-07450



N

R. 55W

OIL & GAS
CONSERVATION COMMISSIONT.
7
N

Scale ... 1" = 1000'

Powers Surveyors, Inc. of Denver, Colorado
has in accordance with a request from Mr. Palmer
for Bander & Couch determined the
Location of No. 1 well
to be QNW SE Section 7 Township 7N
Range 55W of the 6th Principal Meridian
Logan County, Colorado

I hereby certify that this plat is an
accurate representation of a correct
survey showing the location of



00621969

6-21-65

Billy D. Holloway
Licensed Land Surveyor No. 2853
State of Colorado