



FORM F-106



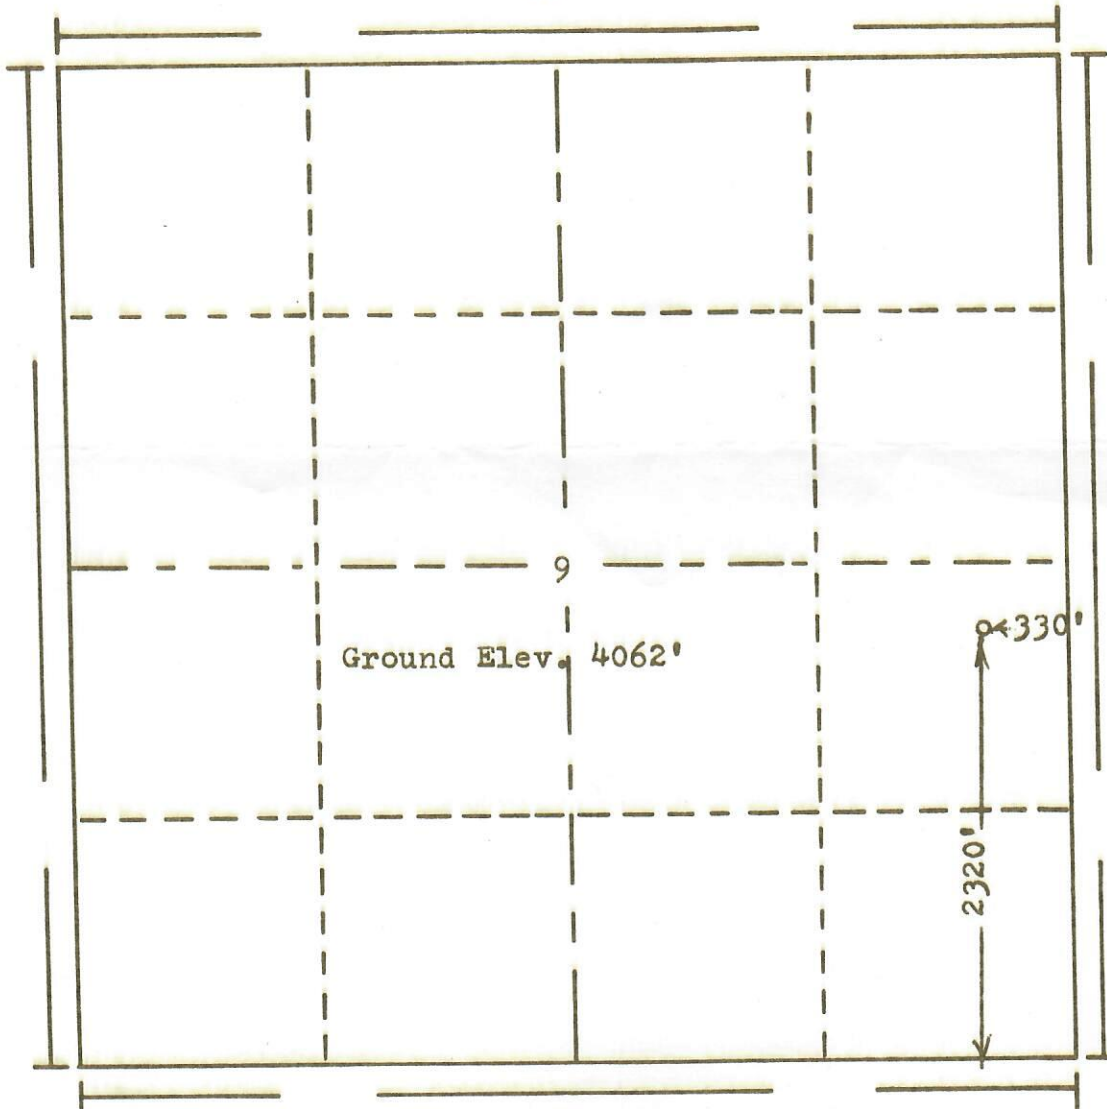
00209121

RECEIVED

SEP 23 1970

COLO. OIL &amp; GAS CONS. COMM.

R. 53W

T.  
7  
N

Scale... 1" = 1000'

Powers Elevation Company, Inc. of Denver, Colorado  
has in accordance with a request from Mr. Brown  
for Plains Exploration Co.

determined the location of No. 1 Lebsack  
to be NE NE SE Section 9 Township 7N  
Range 53W of the 6th Principal Meridian  
Logan County, Colorado

I hereby certify that this plat is an  
accurate representation of a correct  
survey showing the location of

Date: 9-17-70

Bing J. Holman  
Licensed Land Surveyor No. 2853  
State of Colorado

70-482