

RECEIVED

NOV 6 1968

COLO. OIL & GAS CONS. COMM.




00209144

HOLLY RESOURCES CORPORATION

11-4-68

TOWNSHIP 7N RANGE 53W COUNTY LOGAN STATE COLORADO

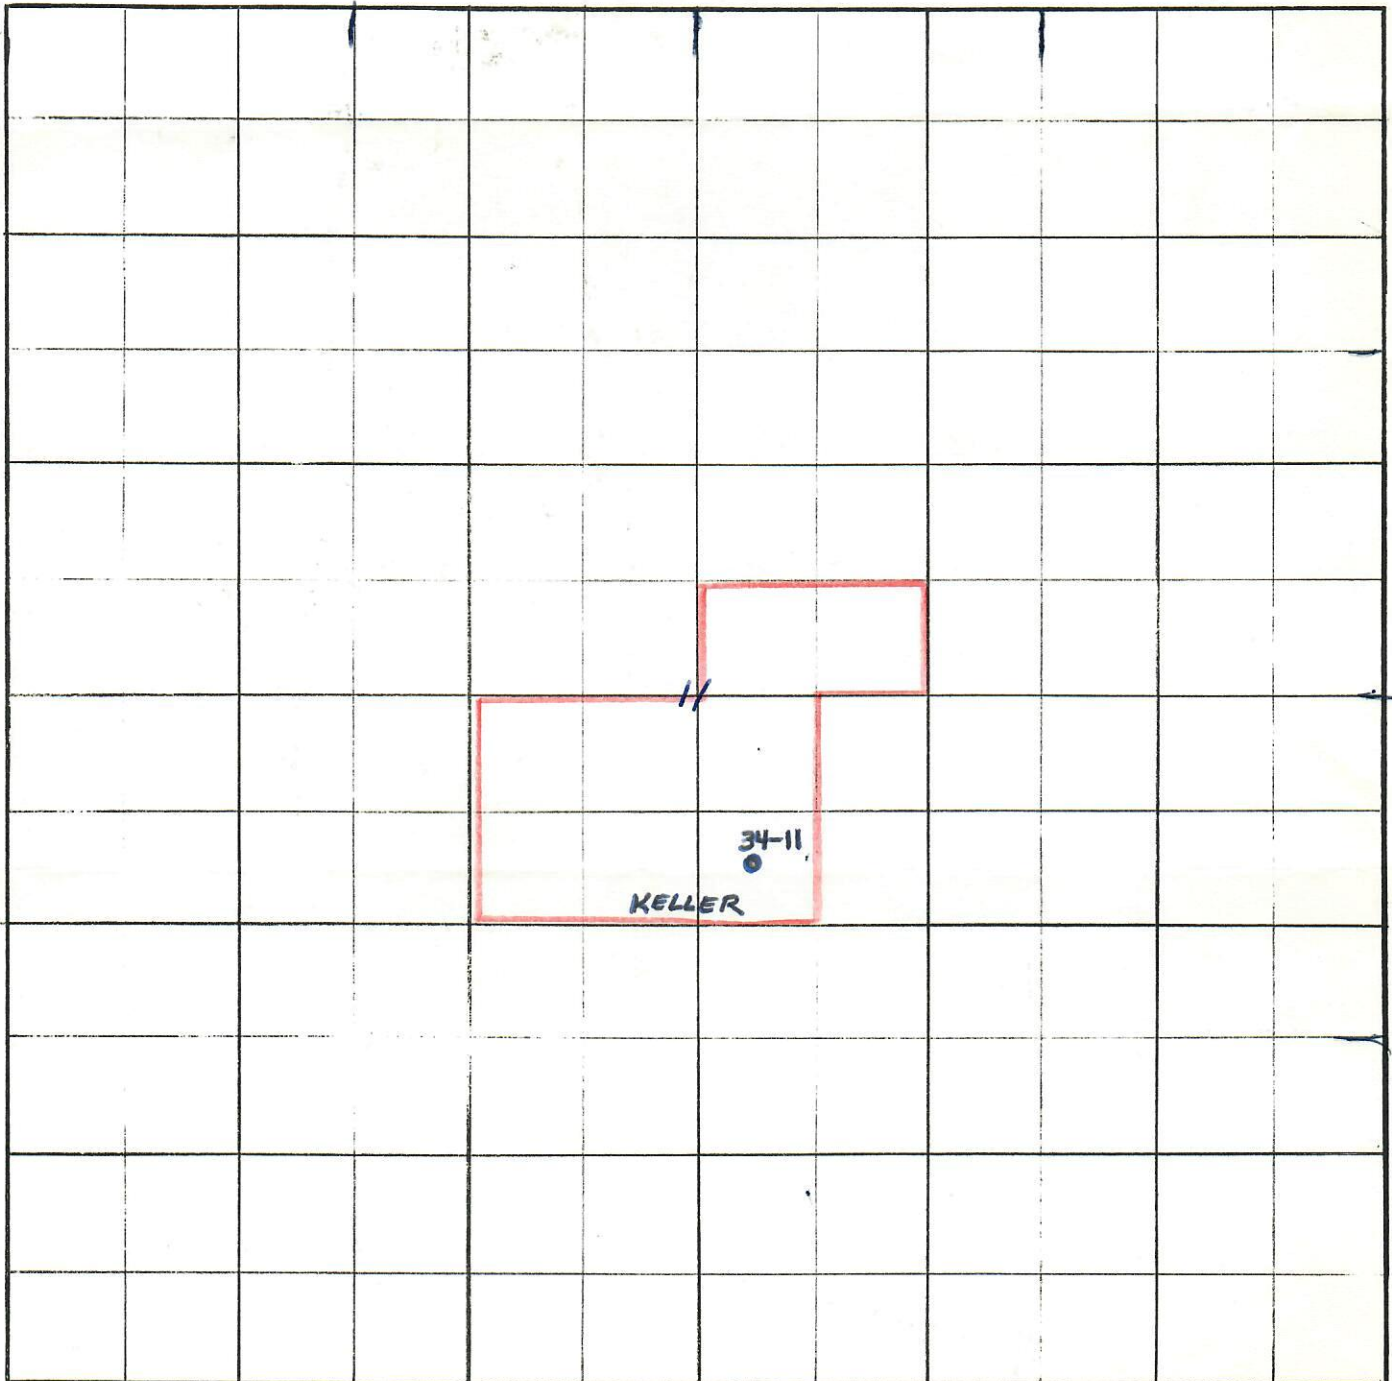

E. B. Granville