




RECEIVED

DEC 27 1979

R. 52W

COLO. OIL & GAS CONS. COMM.

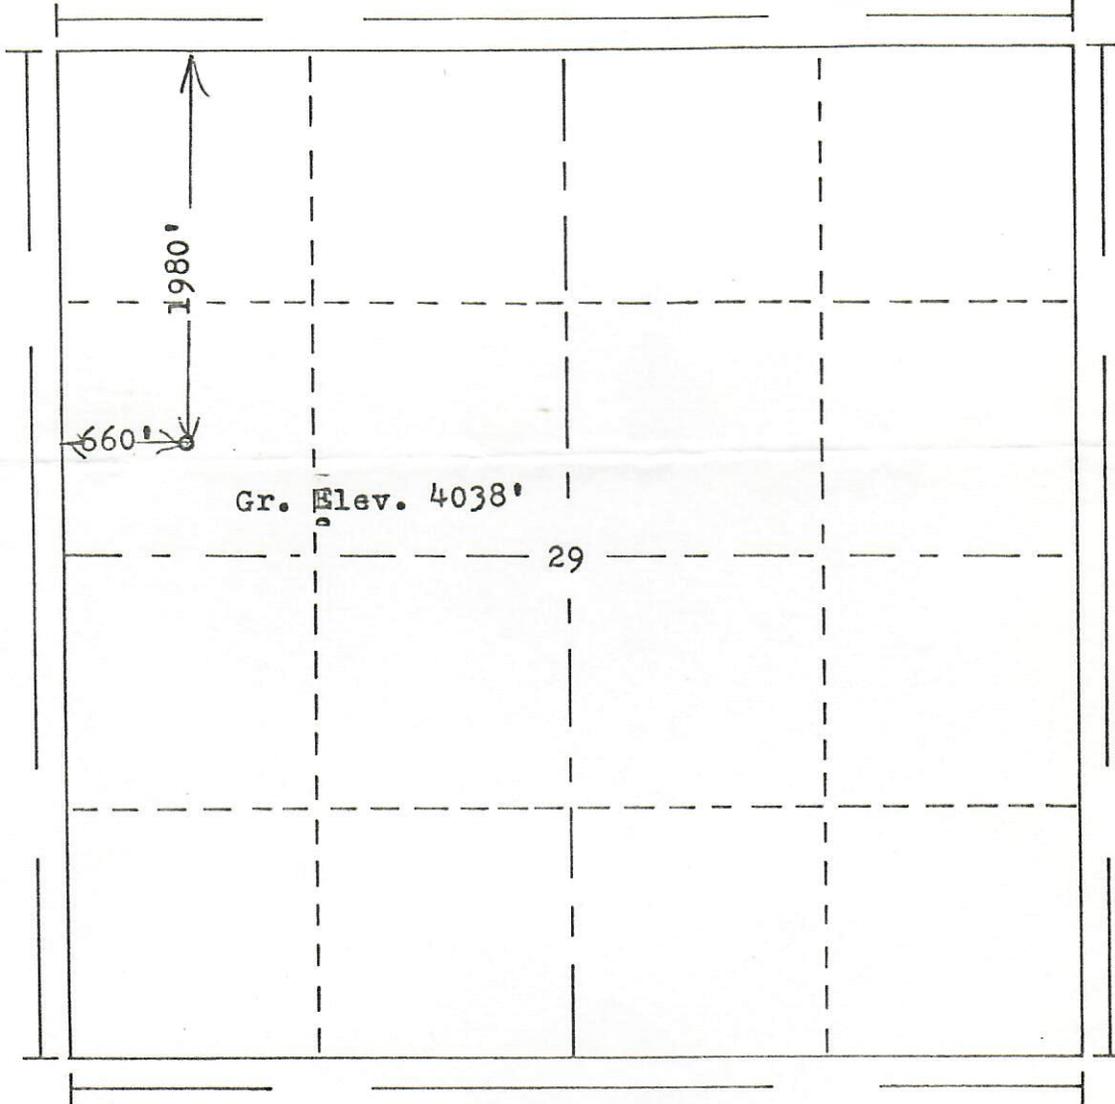

T.
7
N

Scale... 1" = 1000'

Powers Elevation of Denver, Colorado
 has in accordance with a request from Mr. Gear
 for Miller-Christensen etal
 determined the location of No.1-B State
 to be CSW NW Section 29 Township 7N
 Range 52W of the 6th Principal Meridian
Logan County, Colorado



I hereby certify that this plat is an
 accurate representation of a correct
 survey showing the location of

Date: 11-9-79

Brian A. Hoover
 Licensed Land Surveyor No. 2853
 State of Colorado