


99999999

075-05516

R. 54 W.

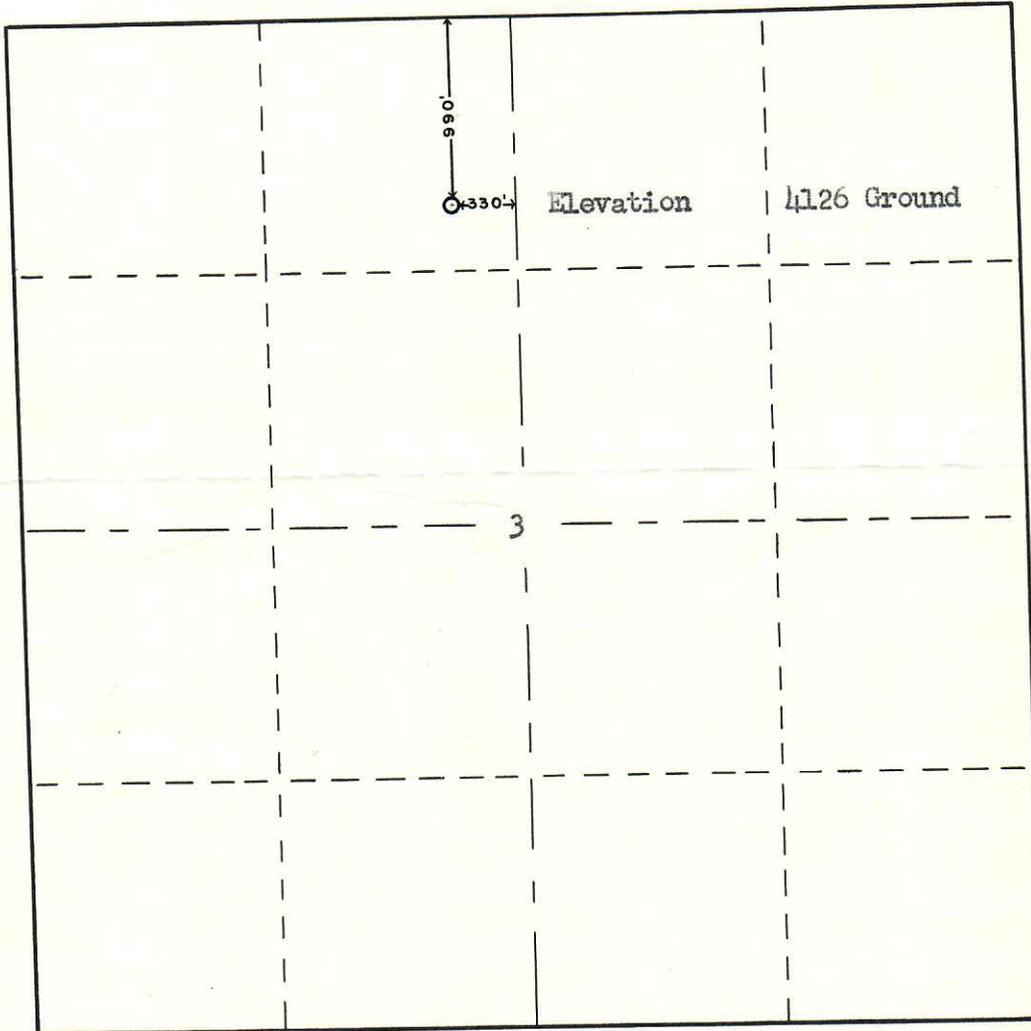

T.  
7  
N.

Scale ... 1" = 1000'

Powers Elevation Company of Casper, Wyoming  
 has in accordance with a request from Mr. Phil Glasser  
 for Eisenhower Drlg determined the

Location of #1 Whittenbaugh  
 to be SE NE NW Section 3 Township 7 North  
 Range 54 West 6th Principal Meridian  
 Logan County, Colorado

The above Plat shows the location of the well site  
 in said section.



00198123

Powers Elevation Company  
 by: *Burr Leibert*  
 Burr Leibert  
 Registered Land Surveyor

Date: 4/27/53