



00270013


	QTR	QTR	SEC	TWNS	RANGE	PM	NAME	DEPTH	TPERF	BPERF
A		C	16	090N	0530W	S	COLO STATE BOARD LAND COMM	400		
B	SE	NW	18	090N	0530W	S	MONTAGUE JOE	430		
C	SW	NW	19	090N	0530W	S	SHELL OIL COMPANY	698		
D	SE	SE	19	090N	0530W	S	SHELL OIL COMPANY	700		
E	NW	SW	19	090N	0530W	S	SHELL OIL COMPANY	700		
F	SE	SW	20	090N	0530W	S	GREEN BROTHERS	380		
G	SW	SW	21	090N	0530W	S	SCHROEDER LESLIE	410		
H	NE	NE	23	090N	0530W	S	BOLLISH DONALD	440		
I	SE	NW	23	090N	0530W	S	SCHROEDER LESLIE	455	355	455
J	SE	SE	23	090N	0530W	S	SKAER ENTERPRISES			
K	SE	NE	24	090N	0530W	S	MAHONEY CHARLES V & NANCY E	324		
L	SW	NW	24	090N	0530W	S	BOLLISH ROBERT	345		
M	SW	SW	24	090N	0530W	S	WERNER DON C & SMITH DON K	318		
N	SW	SW	24	090N	0530W	S	SLATER TIM & JONI	705	480	705
O	SW	SW	24	090N	0530W	S	SLATER TIM & JONI			
P	NE	NW	25	090N	0530W	S	SKAER ENTERPRISES	610	490	610
Q	NW	NW	25	090N	0530W	S	BOLLISH & SON RANCH	440		
R	SE	SE	25	090N	0530W	S	STANLEY L T	393		
S	SE	SW	25	090N	0530W	S	GLASSBURN DELBERT & KATHY			
T	SE	NE	26	090N	0530W	S	WHITTIER W E COMPANY	355		

Letter=Choice | F10=Mark 1 | PgUp/PgDn=±20 | UpAr/DnAr =±1 | Esc=Quit

02 WATER WELL

OIL AND GAS WELL/WATER WELL

BASE PLAT

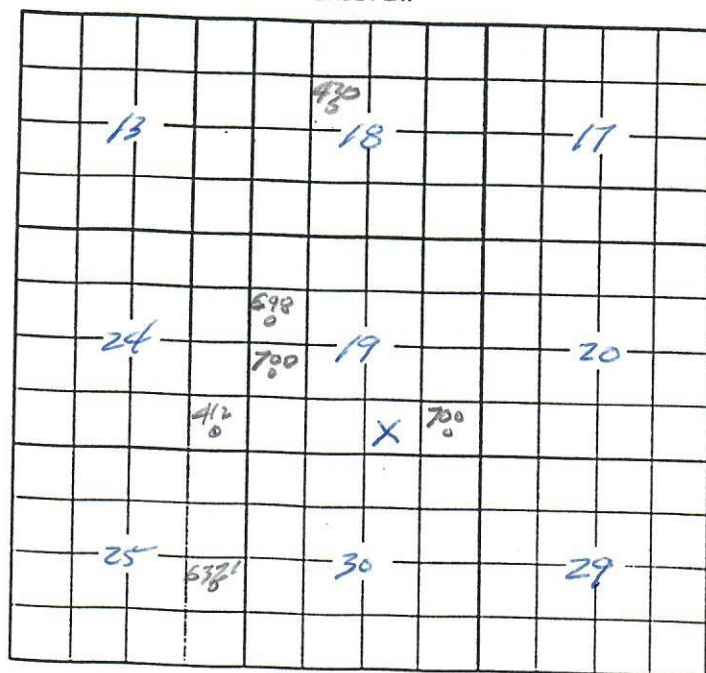

Electrical Log

CO. REPRE.

RECEIVED
FEB 19 1953

[illegible]

SPONTANEOUS-POTENTIAL millivolts	DEPTHS	RESISTIVITY -ohms. m ² /m	RESISTIVITY -ohms. m ² /m
$- \left \begin{array}{c} 20 \\ \hline \end{array} \right . +$	0 0 0 CSG. 170	NORMAL 500	LONG NORMAL 50
		LATERAL 500	INVERTED, LATERAL 50
		AMPLIFIED NORMAL 10	

CSG.
170

0200

0300

0400

0500

0600

0700

0800

0900

