

VERDAD RESOURCES LLC
STATE #1
SECTION 36, T10N, 59W, 6th P.M.
WELD COUNTY, COLORADO

DATE: _____

DESCRIPTION:

[illegible]



PHOTO: VIEW OF AS-DRILLED LOCATION

CAMERA ANGLE: NORTHERLY



PHOTO: VIEW OF AS-DRILLED LOCATION

CAMERA ANGLE: EASTERLY

VERDAD RESOURCES LLC

STATE #1
NE 1/4 SW 1/4, SECTION 36, T10N, R59W, 6th P.M.
WELD COUNTY, COLORADO

TAKEN BY	D.N., J.C	04-03-23	
DRAWN BY	J.G.	04-04-23	
LOCATION PHOTOS			PHOTO 1



UELS, LLC
 Corporate Office * 85 South 200 East
 Vernal, UT 84078 * (435) 789-1017



PHOTO: VIEW OF AS-DRILLED LOCATION

CAMERA ANGLE: SOUTHERLY

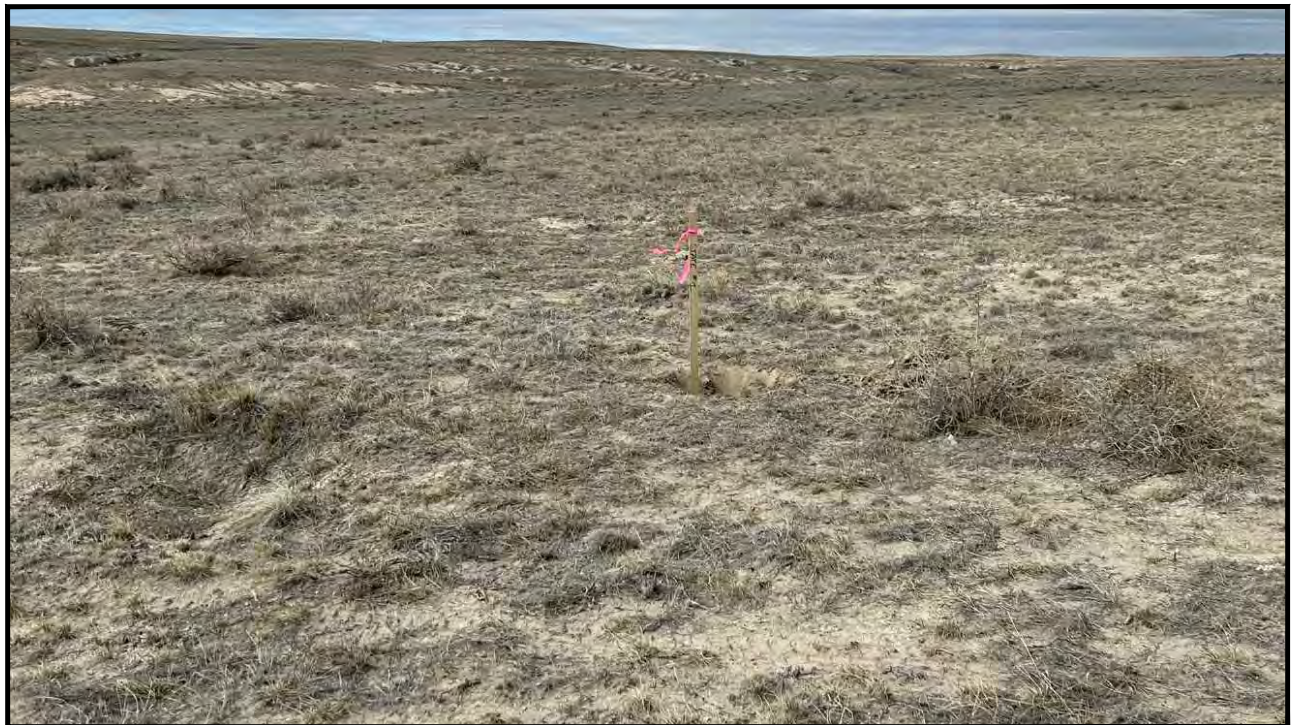


PHOTO: VIEW OF AS-DRILLED LOCATION

CAMERA ANGLE: WESTERLY

VERDAD RESOURCES LLC

STATE #1
NE 1/4 SW 1/4, SECTION 36, T10N, R59W, 6th P.M.
WELD COUNTY, COLORADO

TAKEN BY	D.N., J.C	04-03-23	
DRAWN BY	J.G.	04-04-23	
LOCATION PHOTOS			PHOTO 2



UELS, LLC
 Corporate Office * 85 South 200 East
 Vernal, UT 84078 * (435) 789-1017

Well Name	Lat: (NAD 27)	Long: (NAD 27)	Lat: (NAD 83)	Long: (NAD 83)	Section	Township	Range	Qtr./Qtr.	DATE COMPLETED	PDOP	OPERATOR
STATE #1	40°47'35.63" (40.793231°)	-103°55'42.80" (-103.928554°)	40°47'35.58" (40.793218°)	-103°55'44.61" (-103.929058°)	36	T10N	R59W	NE/SW	4/3/2023	1.2	DALLAS NIELSEN

