



OIL AND GAS CONSERVATION COMMISSION OF THE STATE OF COLORADO

DECEMBER APR 7 - 1961 OIL & GAS CONSERVATION COMMISSION

NOTICE OF INTENTION TO DRILL


INSTRUCTIONS:

A notice of intention to drill a well shall be filed in duplicate on all Federal and Patented lands, and in triplicate on all State lands. Do not begin operations until approved copy has been received. It is mandatory that the proposed location comply with all rules and regulations of the Commission. Locate well on section grid in proper location, and indicate extent of lease. Unless operations are commenced within 180 days after the date of approval hereof, this approval to drill will become null and void.

Name of Operator Horizon Oil & Gas Co. Phone No. Riverside 1-1817 Address 1620 Republic Bank Bldg. City Dallas 1 State Texas

How is liability secured: Well Bond (Attached) []; Blanket Bond [X]; Waiver [] (Check one)

Lease Name Wray Well No. 1-31 Field Name Midway Wildcat [] County Baca

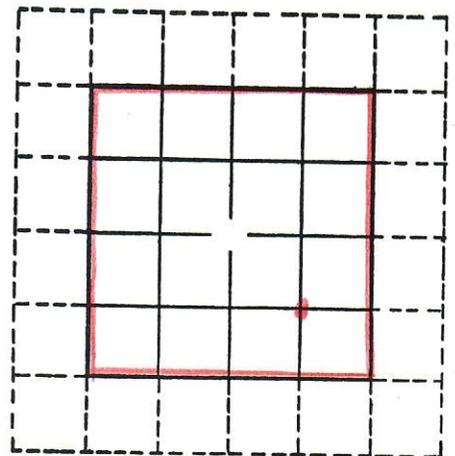

Location C SE/4 (quarter quarter) Section 31 Township 33S Range 42W Meridian 6th P.M. 1320 feet from S Section line and 1320 feet from E Section Line N or S E or W

The well is located on: Patented land [X] State land [] Federal land []

The well is located within a spaced area: Yes [] No [X]

Distance from proposed location to nearest property or lease line 1320 feet. Distance from proposed location to nearest drilling unit line 1320 feet.

Objectives: Topeka Formation Depth 3300' Estimate; - Formation Depth - Estimate

Proposed length of surface casing 500 feet.

REMARKS:

Table with columns for Agent, Bond, Spot, Wells, Oil, Gas, Status. Includes handwritten notes: 69, Blanket, Plotted 4/7/61.

I/We hereby swear (or affirm) that the statements herein made are a full and correct report.

APPROVED: Date APR - 7 1961 Director [Signature]

Company Horizon Oil & Gas Co. Date April 5, 1961 Address 1620 Republic Bank Bldg. Phone No. RI 1-1817 By [Signature] Title Production Manager