

RECEIVED  
NOV 14 1966  
COLO. OIL & GAS COM. COMM.




00595363

That this plat shows the correct location of the C. V. Cogburn Well No. 1, located 1320' FWL and 2640' FSL of Section 12, T33S, R42W, Baca County, Colorado.

November 10, 1966,

Harold E. Burke

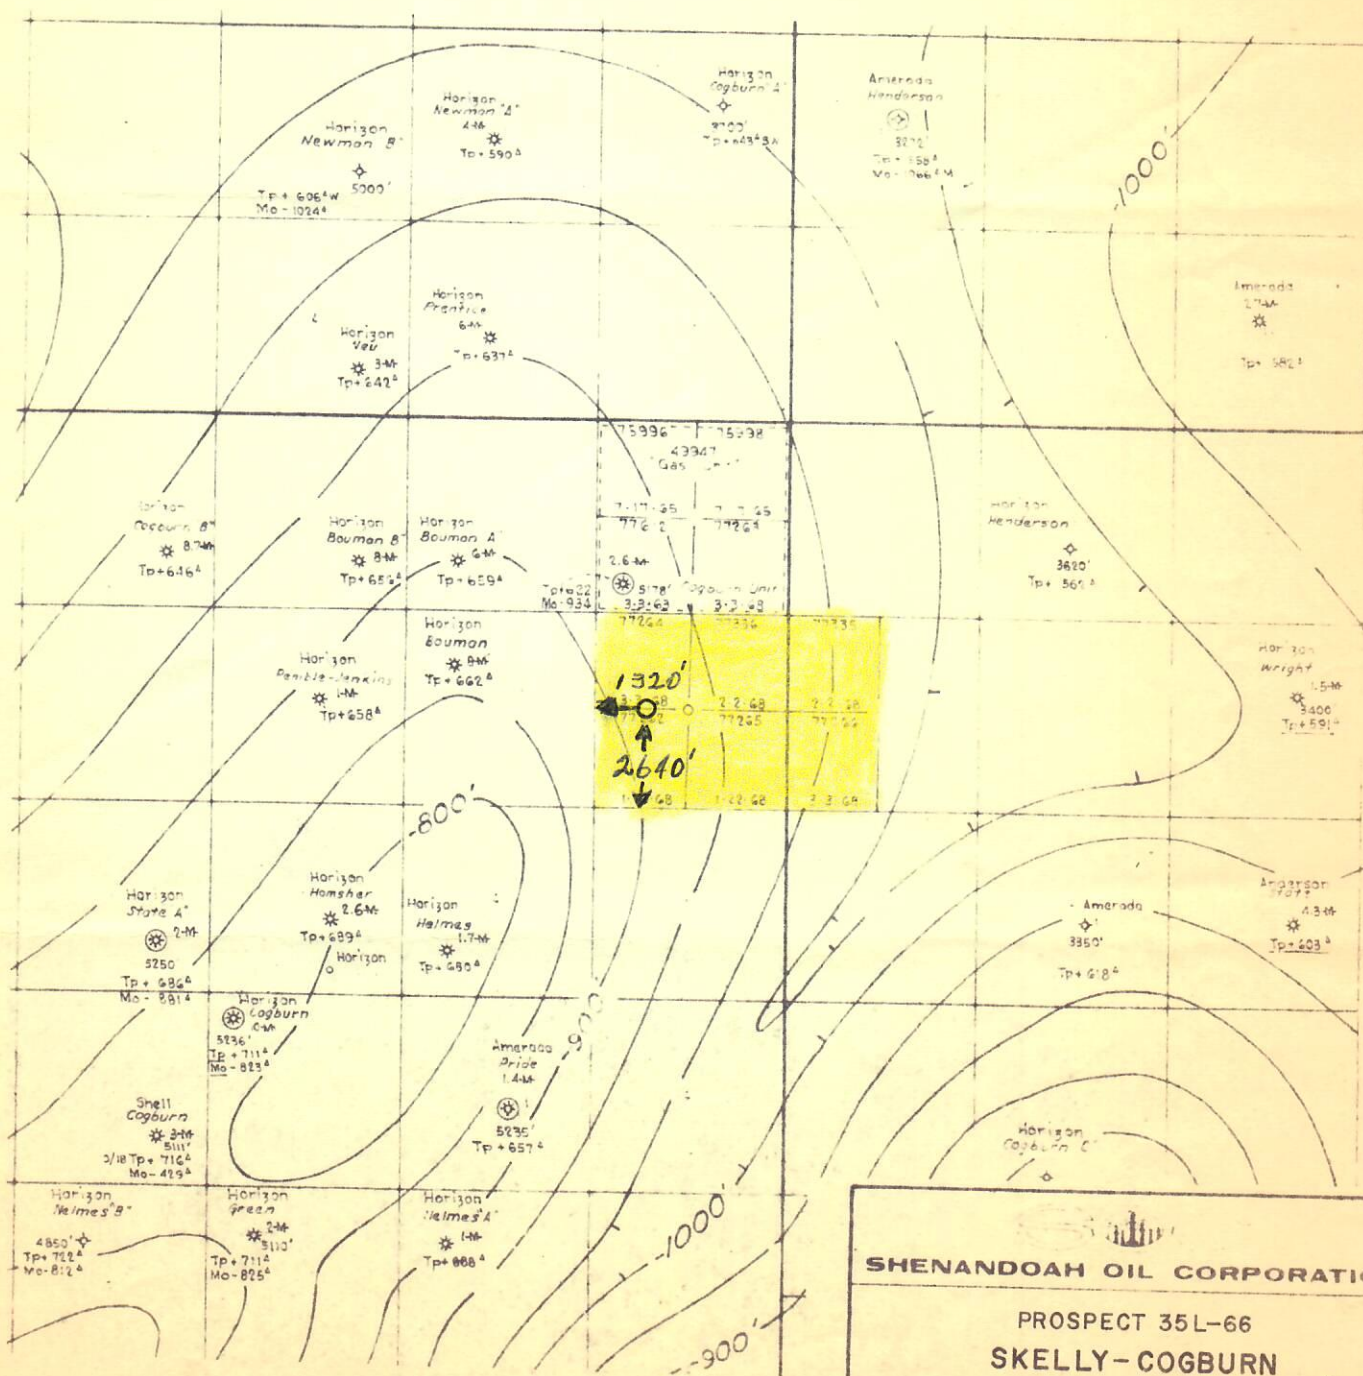

\* = Topeka Production

SHENANDOAH OIL CORPORATION

PROSPECT 35L-66  
SKELLY-COGBURN  
BACA COUNTY, COLORADO  
C SECTION 12-33S-42W  
CONTOURS MORROW STRUCTURE  
CI 50'

SCALE  
0 1/2 MI 1 MI 2 MI

9-22-66