





Lat40°, Inc. 6250 W. 10th Street, Unit 2, Greeley, CO 970-515-5294

PLUGGED AND ABANDONED WELL EXHIBIT

BRIGHTON FARMS LTD #1

SECTION: 31
TOWNSHIP: 1S
RANGE: 66W
6TH. P.M.
ADAMS COUNTY, CO

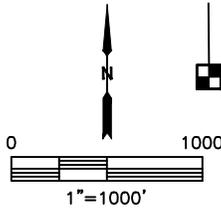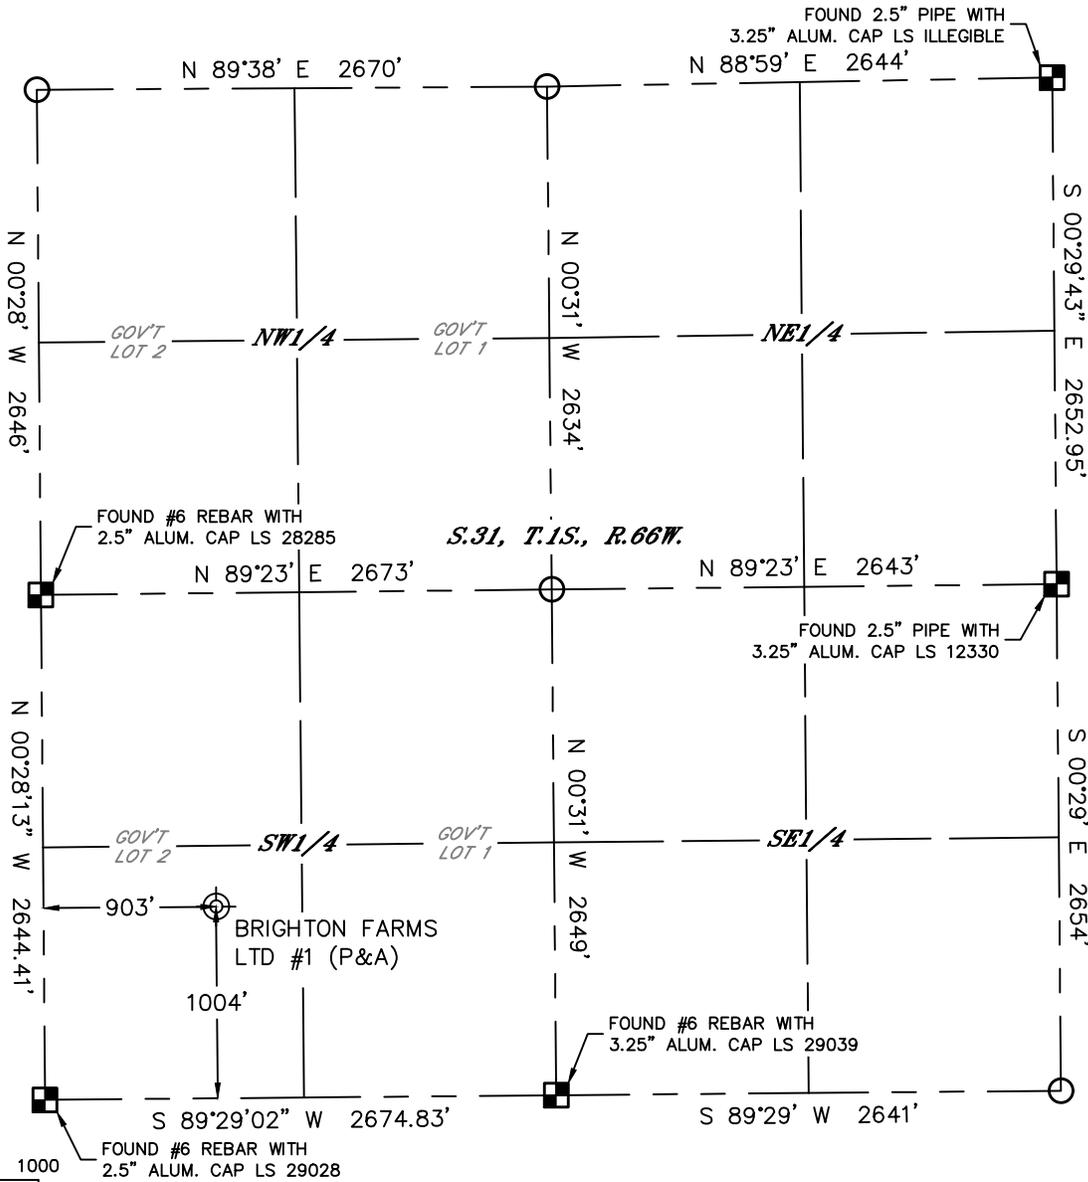


CLIENT: PDC ENERGY, INC.				LANDMAN: PAUL MONTVILLE			
INSTRUMENT OPERATOR: CASEY KOHOUT				SURVEY DATE: 7/13/2023		SURFACE USE: CROPLAND	
SHL FOOTAGE	SHL LAT °	SHL LONG °	SHL PDOP	SHL ELEV (FT.)	SHL 1/4/1/4	SHL S-T-R	
1004 FSL 903 FWL	39.91706	-104.82465	1.1	5067	SWSW	31-1S-66	
DESCRIPTION: LOCATED EXPOSED WELL. FOUND 10" STEEL PIPE WITH CAP							

NOTE:

- 1) Bearings shown are Grid Bearings of the Colorado State Plane Coordinate System, North Zone, North American Datum 1983. The lineal dimensions as contained herein are based upon the "U.S. Survey Foot."
- 2) Distances to section lines measured at 90 degrees from said section lines.
- 3) Ground elevations are based on an observed GPS elevation (NAVD 1988 DATUM).
- 4) Latitude and Longitude shown are (NAD 83 DATUM).
- 5) Sectional data as shown hereon is from previous surveys and was not verified for this P&A Exhibit.
- 6) This map does not represent a boundary survey.

- LEGEND
- = ALIQUOT MONUMENT AS DESCRIBED
 - = CALCULATED POSITION PER EDMUNDSON LE 33-082HC WELL LOCATION PLAT
 - = ABANDONED WELL

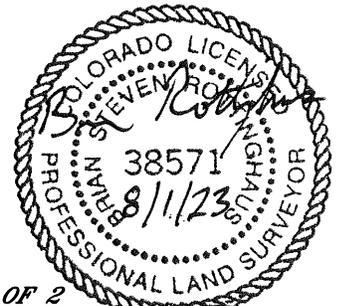

SHEET 1 OF 2
 Brian S. Rottinghaus—On behalf of Lat40°, Inc.
 Colorado Licensed Professional Land Surveyor No. 38571
 DATE: 8/1/2023
 PROJECT#: 2023249



Lat40°, Inc. 6250 W. 10th Street, Unit 2, Greeley, CO 970-515-5294

PLUGGED AND ABANDONED WELL EXHIBIT

BRIGHTON FARMS LTD #1

SECTION: 31
TOWNSHIP: 1S
RANGE: 66W
6TH. P.M.
ADAMS COUNTY, CO
DATE: 7/13/2023



VIEW NORTH



VIEW WEST



VIEW EAST



VIEW SOUTH