


TO: ROGER C. HANKS & A.R. DILLARD, JR. WICHITA FALLS, TEXAS.
LEASE LOCATION SEC. 33, T. 33S, R. 43W, 6TH PM.
WELL NAME ROGER C. HANKS 1 - VICTOR, BARODA LOCATION CEN NW 1/4 NE 1/4
COUNTY BACA STATE COLORADO

W
E
S

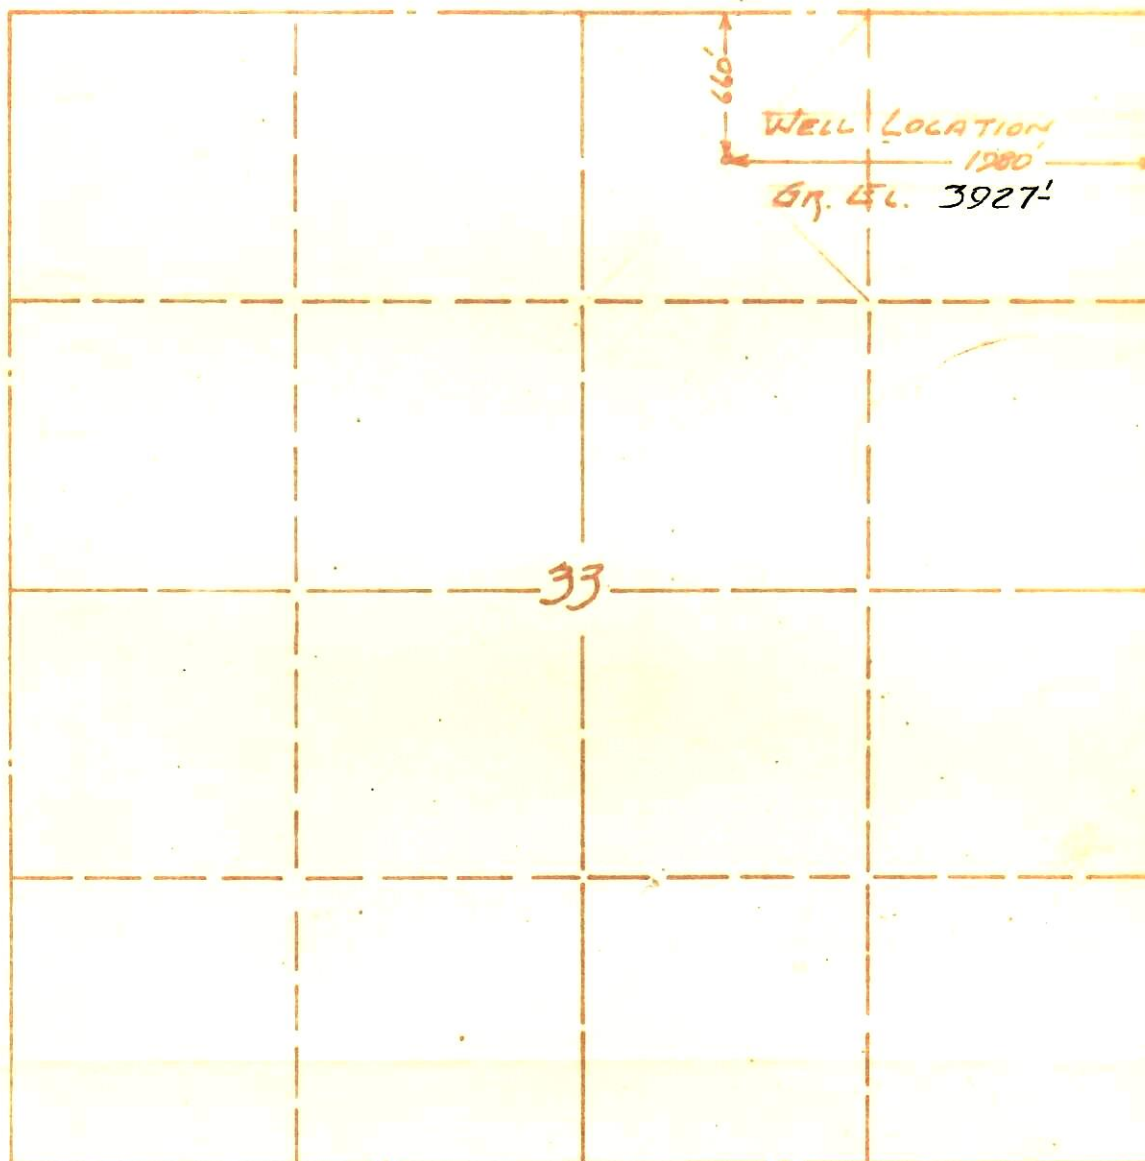

BEST IMAGE
AVAILABLE

I, HEREBY CERTIFY THAT THE WELL LOCATION
SHOWN ON THE ABOVE PLAT WAS STAKED AND
MEASURED AS SHOWN ON THIS PLAT.

DATE 30-11-1964



Shale H. Hillier
REGISTERED ENGINEER
LAMAR, COLORADO



RECEIVED

DEC - 2 1964

REGISTRATION COMMISSION