


To: HORIZON OIL & GAS CO., INC.  
LEASE UNIT - SEC. 36, T. 33 S., R. 13 W., 6 E. P.M.  
WELL NAME HORIZON OIL & GAS CO. STATE "C" LOCATION ENE SE 4 SE 4  
COUNTY BALA STATE C.O.D.

N  
W  
E  
S

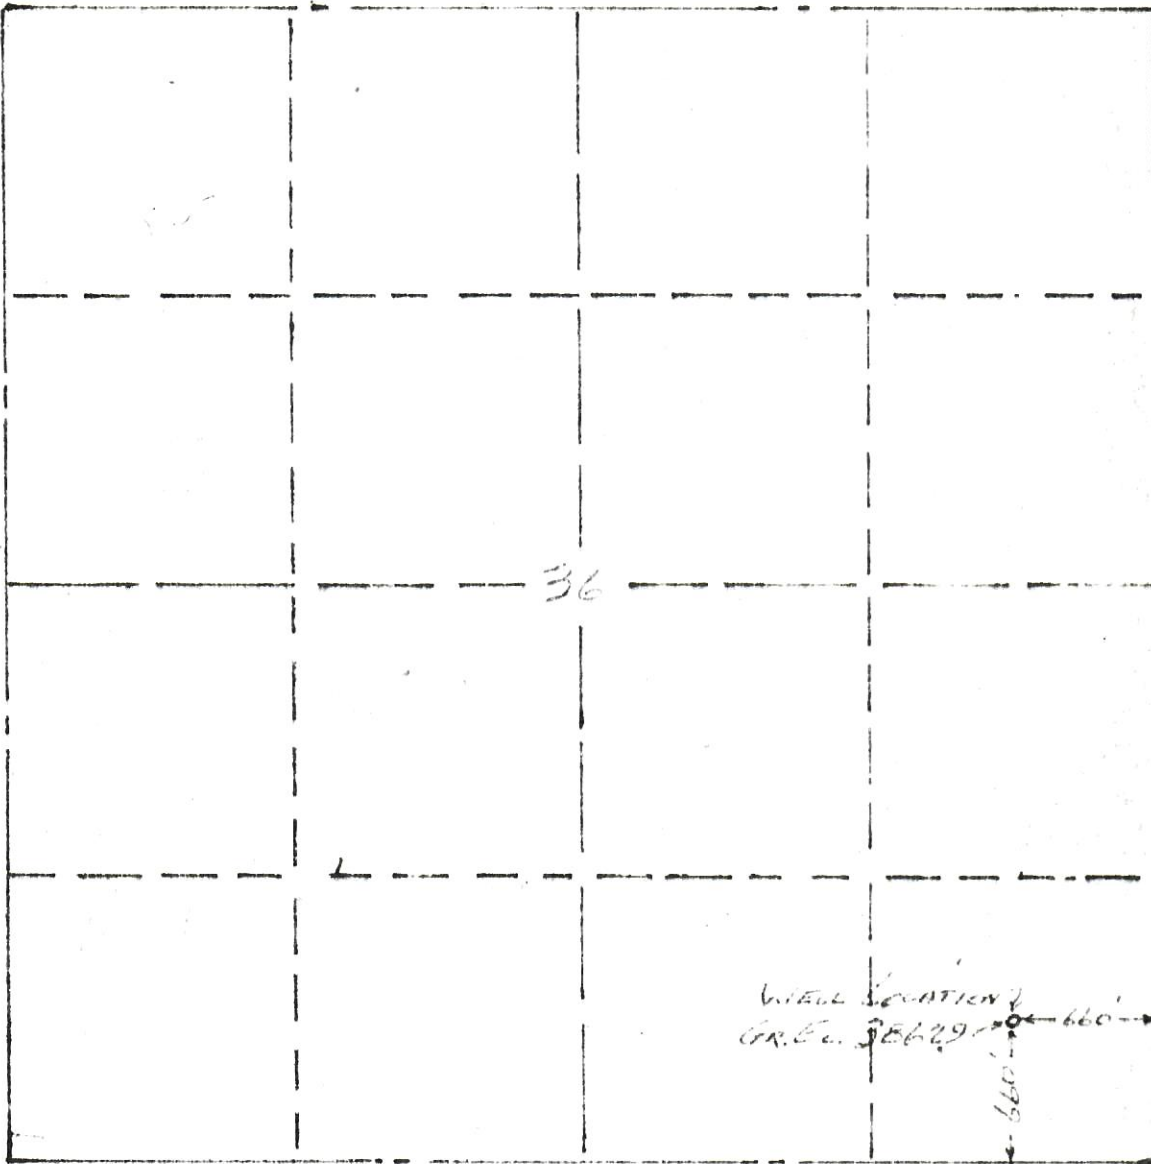

BEST COPY AVAILABLE



RECEIVED

SEP 16 1977

COLD. OIL & GAS CONS. COMM.

DATE 17 APRIL 1974

Richard H. H. H.  
REGISTERED  
C.O.D.