



Holloway & Holloway, Inc.
 P.O. Box 3331
 Greeley, CO 80633
 (303) 867-3715
 (303) 352-5852





NW cor. re-bar
 in roadway
 Basis of elev
 spot elev at
 NW cor. 5190'

R68W

NE cor. line CL
 roads from North & East

N

W 1/4 cor. re-bar
 in roadway

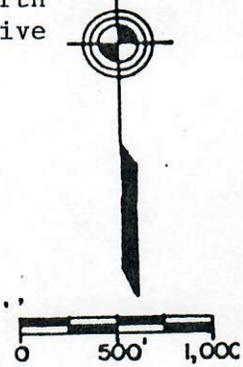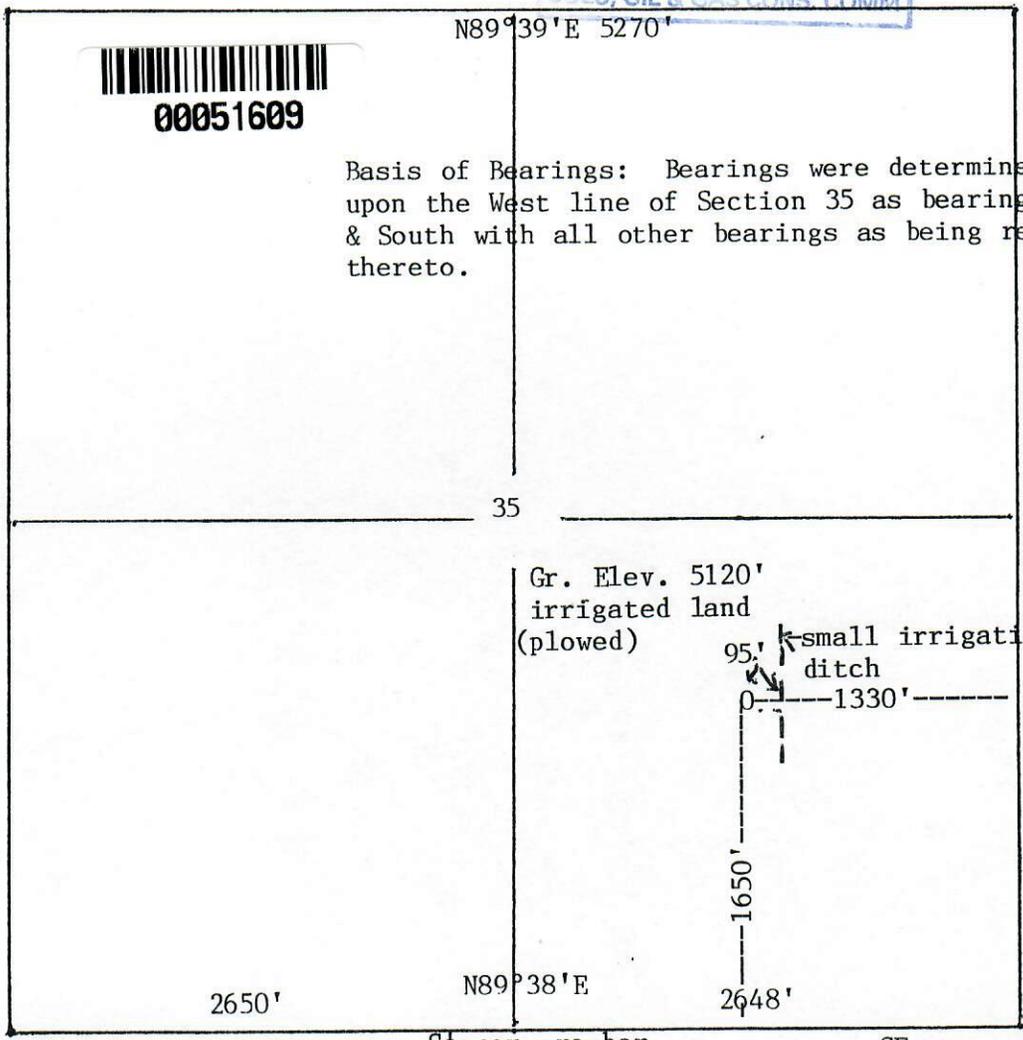

SW cor. re-bar
 in CL highway 7

S 1/4 cor. re-bar
 in roadway

SE cor. re-bar in roadway

Scale - - - 1" = 1000'

In accordance with a request from H.S. Resources, Inc.
 the Undersigned has determined the location of the HSR-Amelia & Elizabeth 10-35 well
 to be 1650'FSL & 1330'FEL at right angles as co-ordinates
 Section 35 Township 1N Range 68W of the 6th principal Meridian
 Weld County, Colorado.

I hereby certify, H.S. Resources, Inc.
 that this oil and/or gas well location certificate was prepared for
 that it is not a land survey plat or improvement survey plat and that it is not to be relied upon for the
 establishment of fence, building or other future improvement lines

Date 5-13-98

Bill J. Holloway
 Holloway & Holloway, Inc.
 State of

