


TO: HORIZON OIL & GAS CO. DALLAS TEXAS
LEASE LOCATION SEC 21, T.33S., R. 43W., 6th P.M.
WELL NAME MALMBERG 1-21 LOCATION CEN NW¹SE⁴
COUNTY BACA STATE COLO.



00640140

RECEIVED
NOV 13 1964

OIL & GAS
CONSERVATION COMMISSION

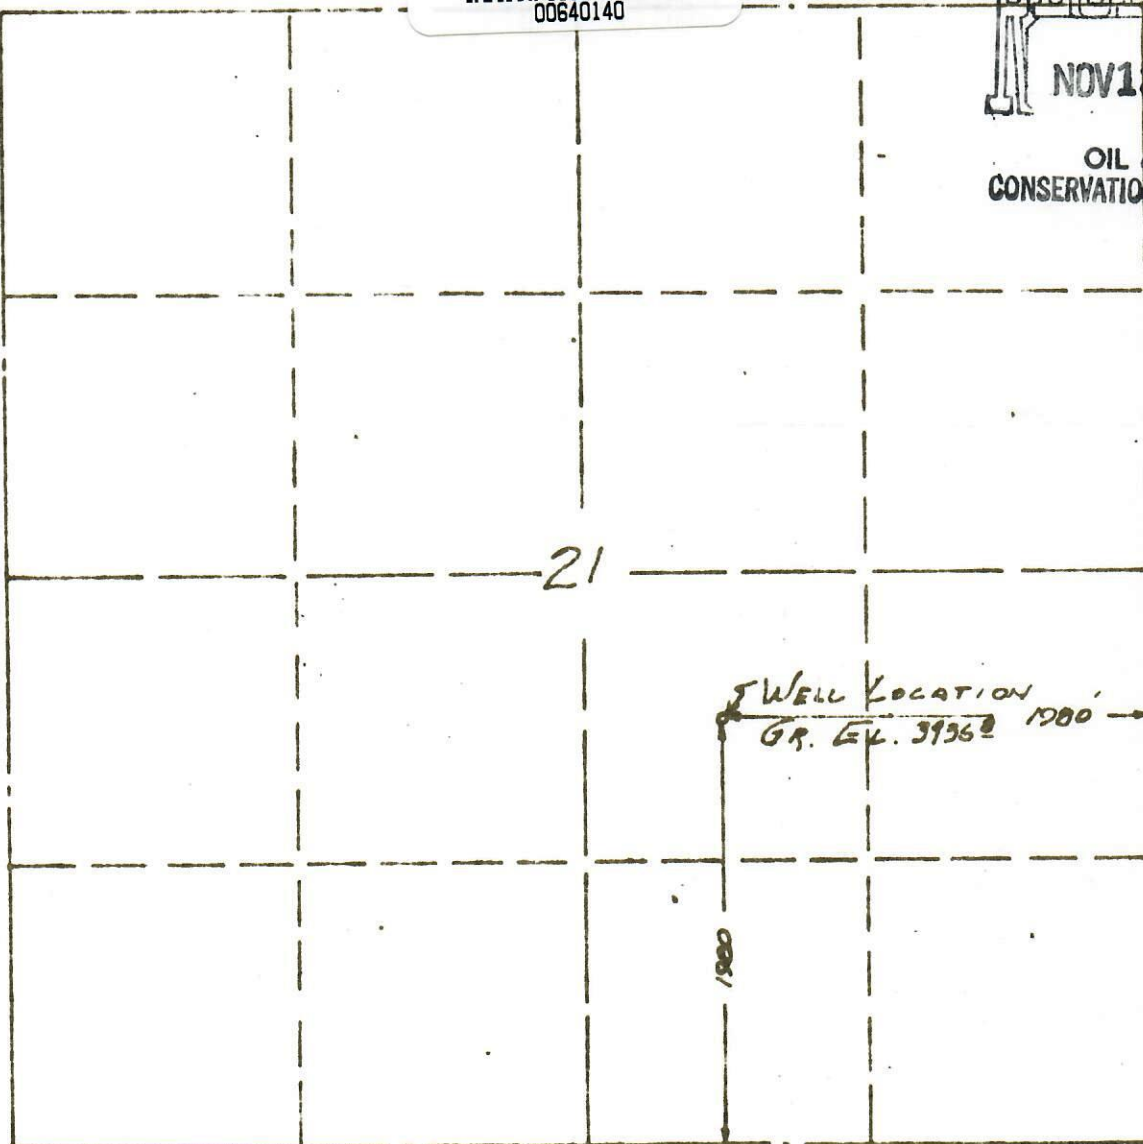

I HEREBY CERTIFY THAT THE WELL LOCATION
SHOWN ON THE ABOVE PLAT WAS STAKED AND
MEASURED AS SHOWN ON THIS PLAT.

DATE



Shah A. R. Lillier
REGISTERED ENGINEER
LAMAR, COLO.

64-507