



01133338

OIL AND GAS CONSERVATION COMMISSION OF THE STATE OF COLORADO

RECEIVED OCT 27 1964 OIL & GAS CONSERVATION COMMISSION

Permit No. 64 482 NOTICE OF INTENTION TO DRILL


INSTRUCTIONS:

A notice of intention to drill a well shall be filed in duplicate on all Federal and Patented lands, and in triplicate on all State lands. Do not begin operations until approved copy has been received. It is mandatory that the proposed location comply with all rules and regulations of the Commission. Locate well on section grid in proper location, and indicate extent of lease. Unless operations are commenced within 180 days after the date of approval hereof, this approval to drill will become null and void.

Name of Operator Horizon Oil & Gas Co. and Henry Frost Oil Properties Address P.O. Box 7 City Spearman State Texas 79081 Phone No. 659-2544

How is liability secured: Well Bond (Attached) []; Blanket Bond [X]; Waiver [] (Check one)

Lease Name State "E" Well No. 1-16 Field Name WALSH Wildcat [X] County Baca []

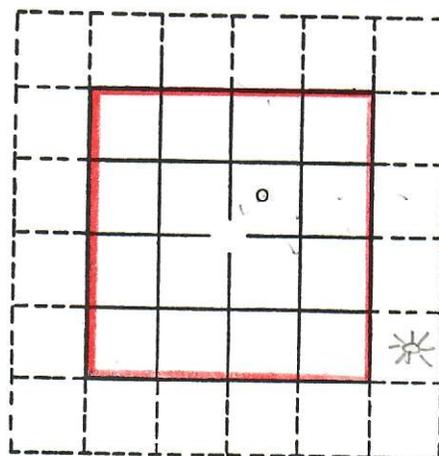

Location SW/NE (quarter quarter) Section 16 Township 33S Range 43W Meridian 6th P.M. 1980 feet from N Section line and 1980 feet from E Section Line N or S E or W

The well is located on: Patented land [] State land [X] Federal land []

The well is located within a spaced area: Yes [] No [X]

Distance from proposed location to nearest property or lease line 1980 feet. Distance from proposed location to nearest drilling unit line 1980 feet.

Objectives: Morrow Formation Depth 5400 Estimate; Formation Depth Estimate

Proposed length of surface casing 500 feet.

REMARKS:

Plat to come in

Table with columns for names (DVR, WRS, HHM, JAM, FJP, JJD, FILE) and a 'Plotted' date (10-22-64). Includes handwritten note 'Blanket well file att.'

I/We hereby swear (or affirm) that the statements herein made are a full and correct report.

APPROVED:

Date OCT 27 1964 [Signature] Director

Company Horizon Oil & Gas Co. Date 9-3-64 Address P.O. Box 7, Spearman, Tex. Phone No. 659-2544 By [Signature] Title Prod. Supt. Signature