



00632031

LAUGHLIN-SIMMONS & CO. OF KANSAS, INC.

OIL FIELD SURVEYING
1337 NORTH MERIDIAN, SUITE 2
WICHITA, KANSAS 67203

(316) 943-5351

KW10058324

INVOICE NO.

ANTELOPE PRODUCTION

1

Mayberry

OPERATOR

NO.

FARM

Baca Colo.

4 34s 41w

660'FNL 660'FEL of tract 40

COUNTY

S T R

LOCATION

ELEVATION: 3709 gr

ANTELOPE PRODUCTION
P. O. Box 577
Kimball, Nebraska 69145

RECEIVED

OCT 21 1983

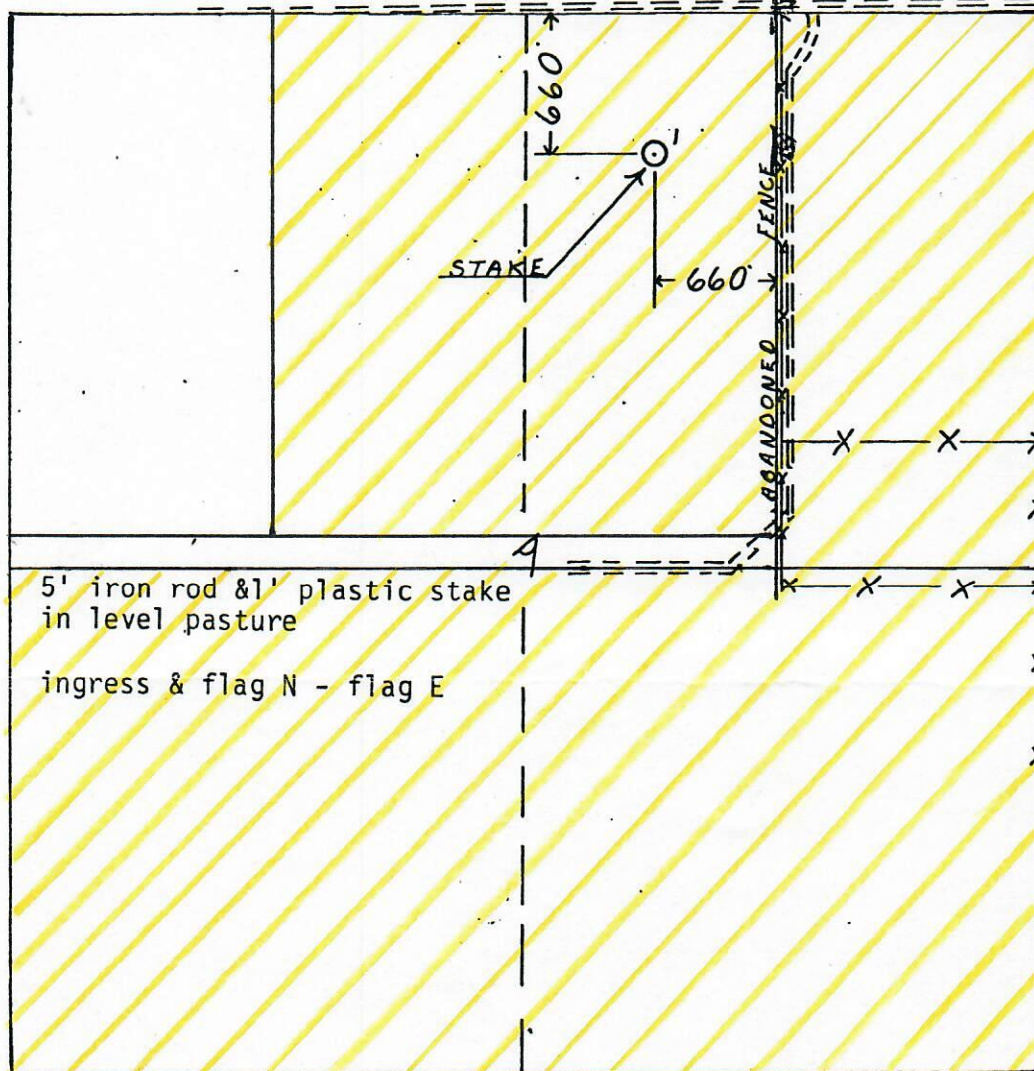
AUTHORIZED BY: Ed Noah

COLO. OIL & GAS CONS. COMM.

SECTION 32

SCALE: 1" = 1000'

SECTION 33

3/4 mile E
1 1/4 mile N
TO HWY 51
"KANSAS &
COLORADO
LINE"