



RECEIVED


DEC 13 1978

COLO. OIL & GAS CONDS. COM.



R. 46W

N

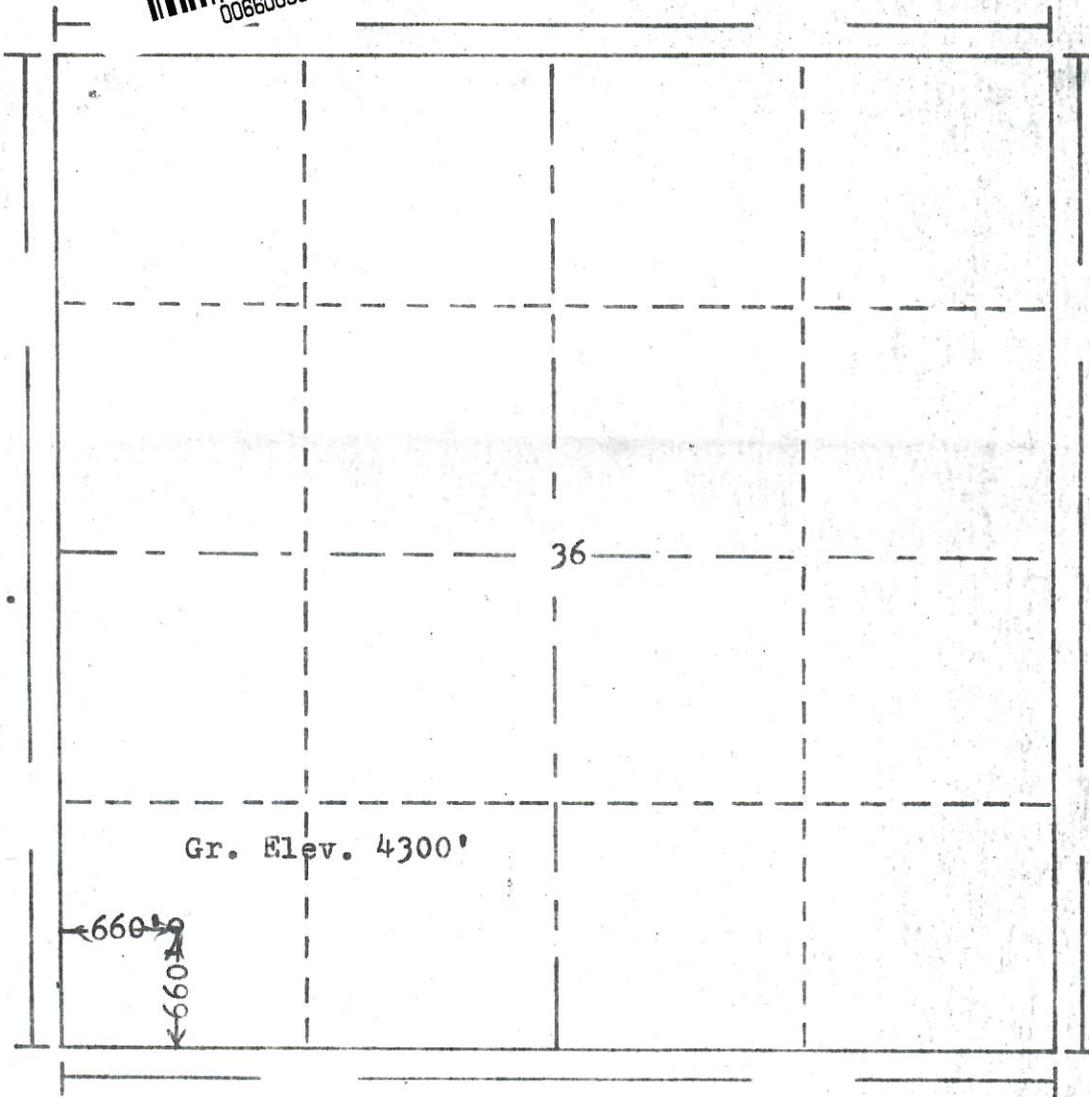

Scale... 1" = 1000'

Powers Elevation Company, Inc. of Denver, Colorado has in accordance with a request from Mr. Fabian for Wexpro Co.

determined the location of No.1-36 Williams to be CSW SW Section 36 Township 33S Range 46W of the 6th Principal Meridian Baca County, Colorado

I hereby certify that this plat is an accurate representation of a correct survey showing the location of

Date: 11-30-78

*Bill J. Hagan*

Licensed Land Surveyor No. 2853 State of Colorado