


REC'D MAR 18 1959

R. 66 W.



00210154

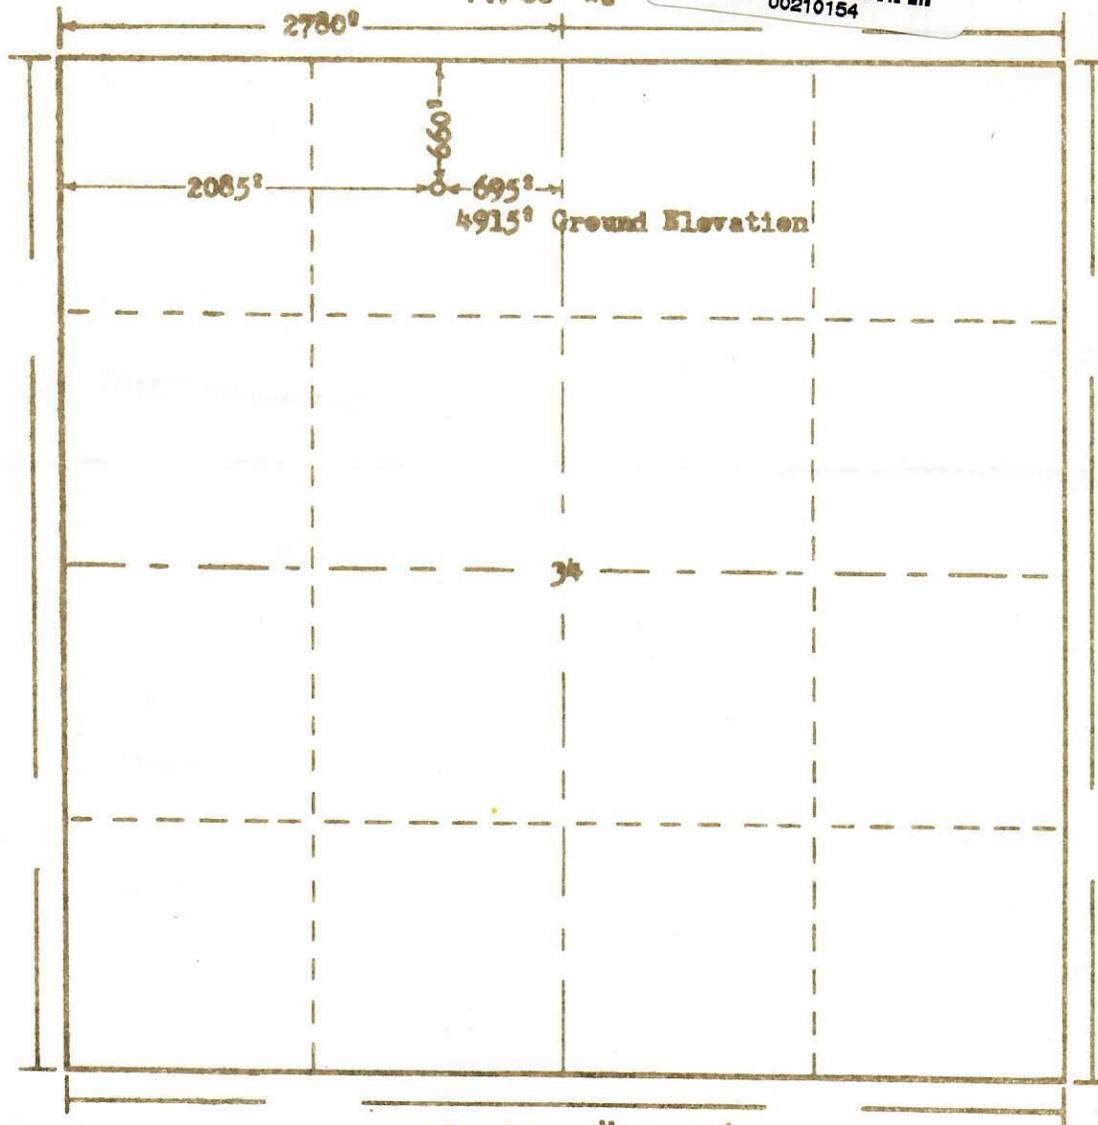

T.
7
N.

Scale ... 1" = 1000'

Powers Elevation Company of Denver, Colorado
 has in accordance with a request from Robert E. Johnson
 for Plains Exploration Company determined the
 Location of #1 Andersen
 to be C NE NW Section 34 Township 7 North
 Range 66 West Sixth Principal Meridian
 Weld County, Colorado.

The above Plat shows the location of the well site
in said section.

Powers Elevation Company

by: *Burr Libbert*

By: Burr Libbert

