



## WELL LOCATION SURVEY

Plat No. 39

OWNER: Service Drilling Company

OF: Well, L. Hamilton # 1, Located Center NE of SW, Section 34-T34S-R41W, Baca

County, Colorado

d. 11-30-73

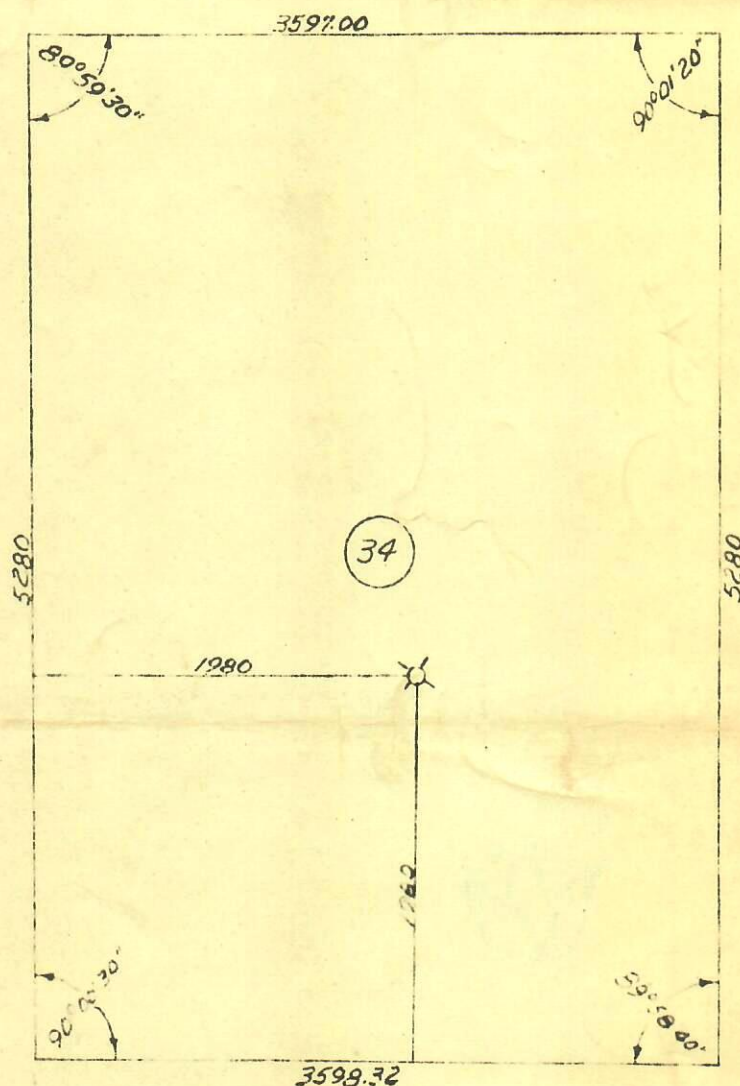
Platted: 12-3-73

Scale 1 Inch = 1,000'

Elevation of Well Location is 3558.8  
Elevation 100' West of Loc. 3558.8  
Elevation 100' South of Loc. 3558.8

RECEIVED  
APR 5 1974

OIL &amp; GAS CONS. COM.

BEST COPY  
AVAILABLE

H. C. Williams

being a Registered Professional Engineer

I, H. C. Williams, State of Colorado Seal No. 4868 do hereby certify that the above plat represents an  
survey made under my supervision and that all measurements, bearings and monuments are correctly shown and  
d on the above plat as found or staked in the field as so dated above.

Bearers: Gene Harris

SIGNED:

Tim Campbell

H. C. WILLIAMS AND ASSOCIATES

Guymon, Oklahoma

Chuck McAnarney

Phone: Day 338-6904 — Night 338-6923