



TOPOGRAPHIC LAND SURVEYORS

Surveying and Mapping for the Energy Industry  
1008 E. 17TH ST. • HAYS, KANSAS 67601

TELEPHONES: LOCAL (913) 625-2683 • OKLA. WATS (800) 522-4273 • OUT OF STATE WATS (800) 654-3219

RECEIVED


MAY 02 1986

COLO. OIL & GAS CONS. COMM.

BACA

County, Colorado

1329' fSL-1357' fWL Section 7 Township 33S Range 43W P.M.

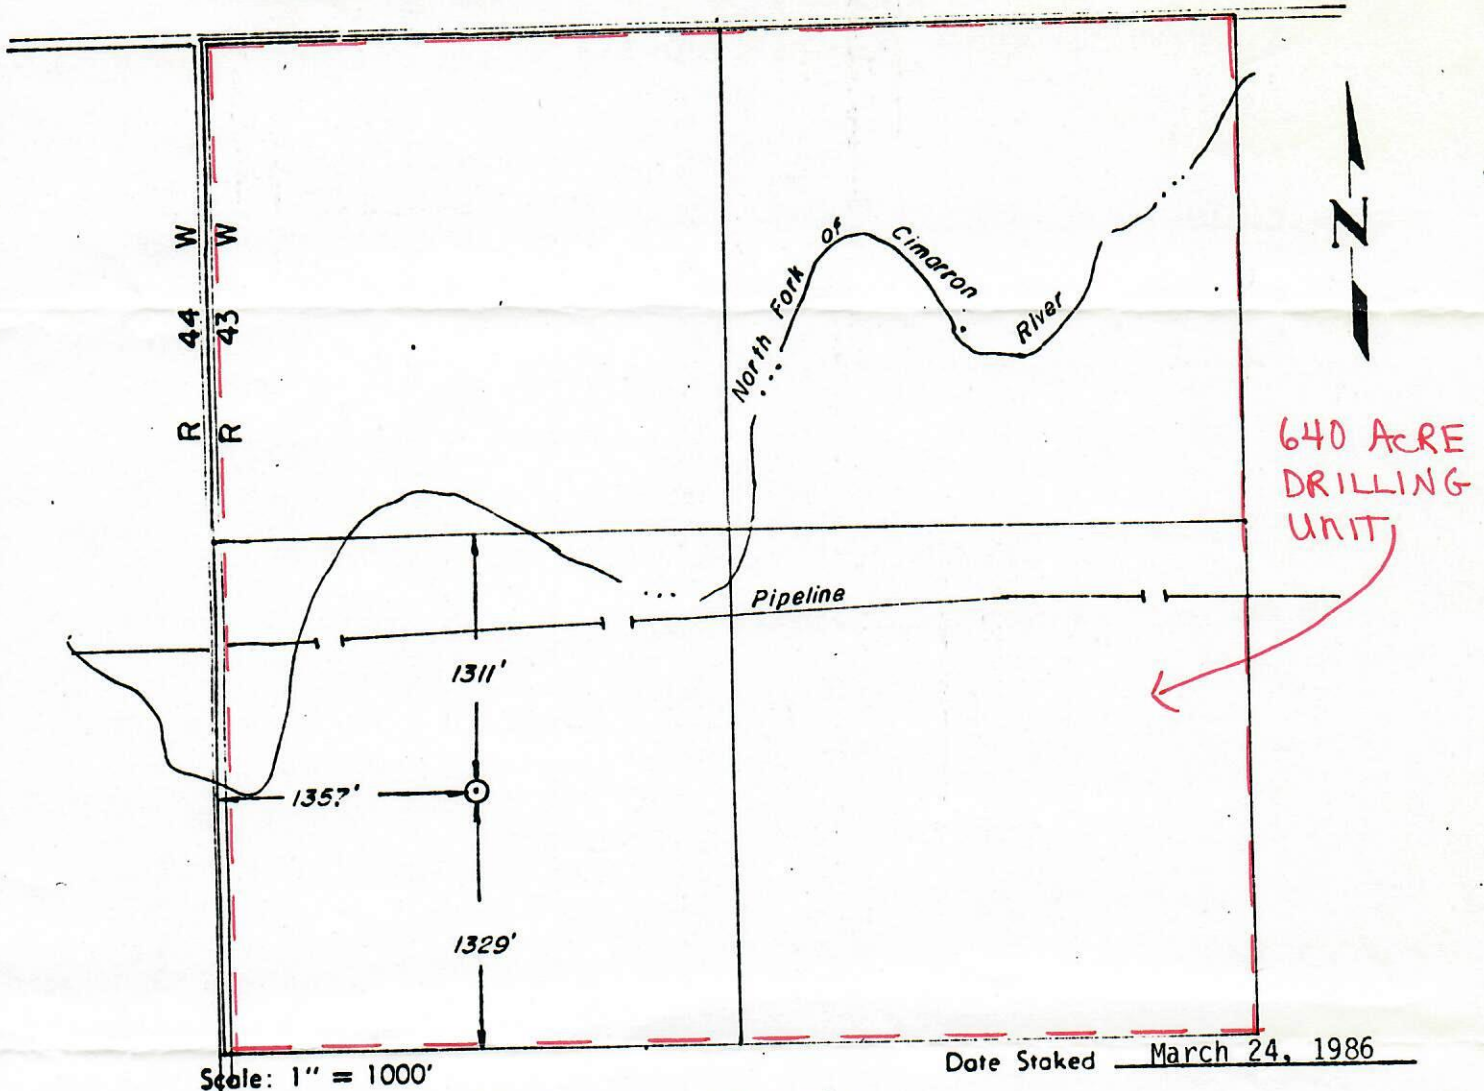

This location has been very carefully staked on the ground according to the best official survey records, maps, and photographs available to us, but its accuracy is not guaranteed.

Review this plat and notify us immediately of any possible discrepancy.

Operator: STRAT LAND EXPLORATION

Lease Name: Cook Well No.: 1-7

ELEVATION:

3993' Gr. at stake

Topography & Vegetation: Milo stubble

Good Drill Site? yes Reference Stakes or Alternate Location Stakes Set none

Best Accessibility to Location: From the West

Distance & Direction from Hwy Jct or Town: From Walsh, CO., go 13 miles South; thence 1 mile

West to the NE Corner of Section 7.

CERTIFICATE:

I, Virgil R. Rogers

an authorized agent of Topographic Land Surveyors, do hereby certify that the above described well location was surveyed and staked on the ground as shown herein.

Virgil R. Rogers