




CERTIFICATE OF SURVEY

BEST COPY AVAILABLE

Cogburn 1-21

Sec. 21 Twp. 33 S Rge. 42 W P.M. 6th

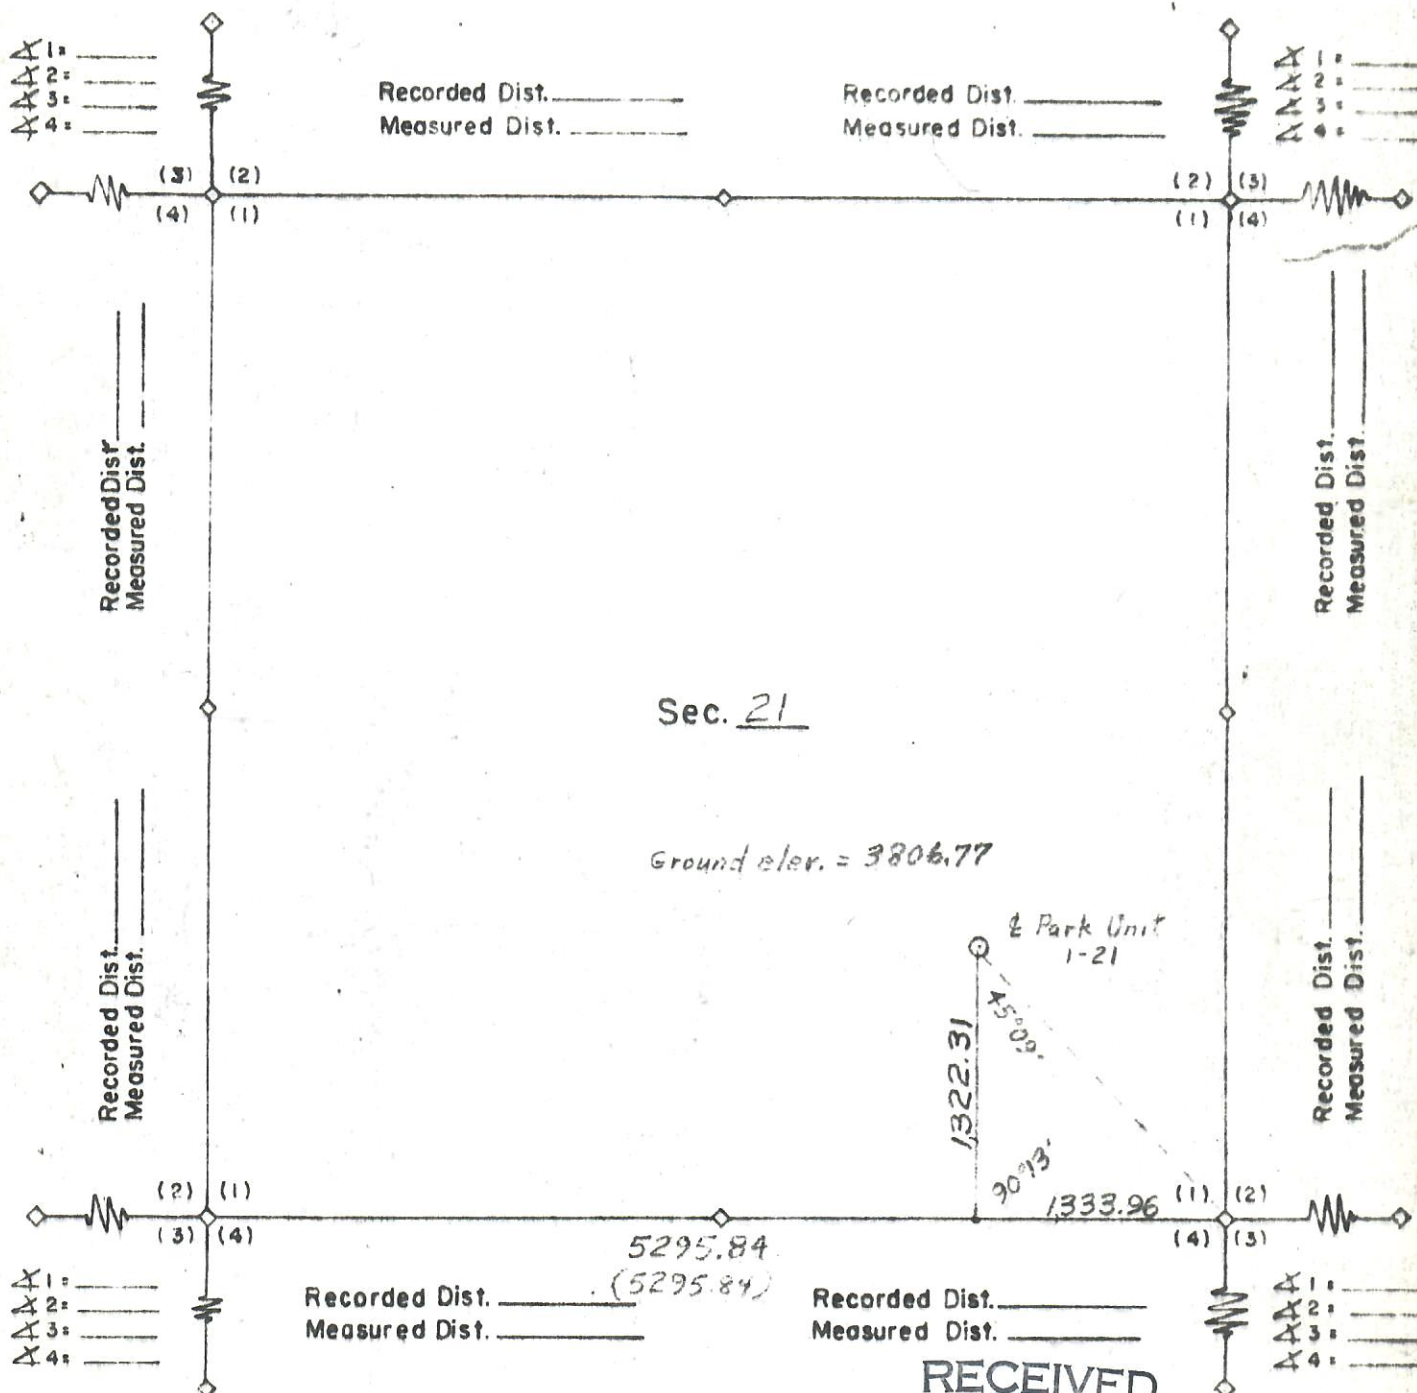

RECEIVED

SEP 16 1977

COLO. OIL & GAS CONS. COMM.

I hereby certify the above plat is an accurate representation of a correct survey showing the location of Shell Oil Company Park Unit # 1-21 Oil Well.

Date of Survey: April 7, 1961

J. S. Lye
Licensed Surveyor
State of: Colo.