OPERATOR:	Summit Oil & Gas LLC - 10774	**CNTY:**	Weld	**FTG:**	660 FSL 1980 FEL	**IP GAS:**	0
WELL:	Nicola 15-35	**STATE:**	CO	**Q-Q:**	SWSE	**IP OIL:**	0
FIELD:	Wildcat - 99999	**ROTARY SPUD:**		**SEC.:**	35	**IP WTR:**	
API #	05-123-12130	**COMP/PA:**	21-Nov-84	**TWS:**	8N	**CUM GAS:**	
LEASE #:	-	**STATUS:**	DA	**RGE:**	59W	**CUM OIL:**	
UIC #:	-	**WBD DATE:**	7-Aug-23	**BY:**	bdd	**CUM WTR:**	
BASIN:	Denver - Julesburg	**LAT/LONG:**	40.612856/-103.941657			**LAST PROD:**	

CURRENT WELLBORE DIAGRAM

KBE: 4851 '
KB: 9 '
GLE: 4842 '

TD (ft): 6685 '
PBTD (ft): 0 '

8 5/8" 24# Csg @ '

Top Laramie Shale @ 1 '
Base Laramie Shale @ 201 '
Top Laramie-Fox Hills @ 201 '
Base Laramie-Fox Hills @ 531 '
Top Pierre Shale @ 531 '
Base Pierre Shale @ 821 '
Top Upper Pierre @ 821 '
Base Upper Pierre @ 1541 '
Top Niobrara @ 3824 '
Top Codell @ '
Top DSND @ 6538 '
Top JSND @ 6616 '

TD @ 6685 '
7 7/8" Hole

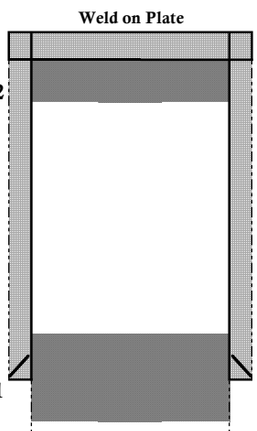

WCR 121 & Hwy 14. N 1.0. W 1.5. N Into.

CASING HEAD: None
WELLHEAD: None

CASING RECORD

HOLE (in)	SIZE (in)	WT (lb/ft)	GRADE	TOP (ft)	BTM (ft)	JTS
12 1/4	8 5/8	24		0	318	

Float Collar @

TUBING RECORD COND: DATE:

SIZE (in)	WT (lb/ft)	GRADE	TOP (ft)	TALLY (ft)	JTS

ITEM	DESC	SIZE (in)	TALLY (ft)	JTS

PERFORATION RECORD

ZONE	TOP (ft)	BTM (ft)	SPF	DATE SHOT	STATUS	STIM

WELLWORK HISTORY

DA since 1984

Hole full of 9.3# mud

Plug 1 = 20 sx from 330' to 270'

Plug 2 = 10 sx from 30' to 0'
Cut off surface 4' below ground level and weld on plate