


SE SW SW sec. 12, T2N, R3W UPM
Mesa County, Colorado

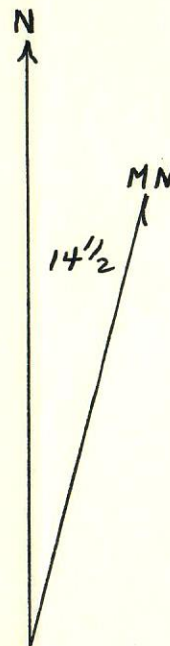

Ralph Bradley
No 2 Globe

©

93'

11 12
14 13

1015'

Ground Elevation 4598'
(Taken from Reclamation map)
Approximate T.D. - 2300'

surveyed by me this date
July 30, 1959

Raymond C. Robeck
consulting Geologist

Scale 1 inch = 100 feet

R. C. ROBECK
535 ORCHARD AVENUE
GRAND JUNCTION, COLO.

00650733