



00065603

OIL AND GAS CONSERVATION COMMISSION
OF THE STATE OF COLORADORECEIVED
FEB 20 1963

NOTICE OF INTENTION TO DRILL

OIL & GAS
CONSERVATION COMMISSION

INSTRUCTIONS:

A notice of intention to drill a well shall be filed in duplicate on all Federal and Patented lands, and in triplicate on all State lands. Do not begin operations until approved copy has been received. It is mandatory that the proposed location comply with all rules and regulations of the Commission. Locate well on section grid in proper location, and indicate extent of lease. Unless operations are commenced within 180 days after the date of approval hereof, this approval to drill will become null and void.

Name of Operator ARROWHEAD OIL COMPANY Phone No. 242-6262
Address 1421 West Sherwood Drive, City Grand Junction State Colorado


How is liability secured: Well Bond (Attached) ☐; Blanket Bond ☒; Waiver ☐
(Check one)

Lease Name C-04283-B

Well No. 13

Field Name Rangely Wildcat ☒

County Rio Blanco

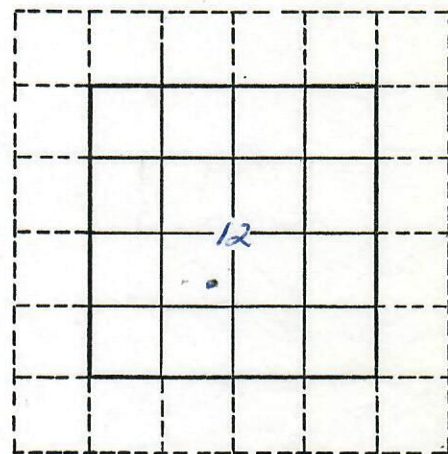

Location NE $\frac{1}{4}$ SW $\frac{1}{4}$ (quarter quarter) Section 12 Township 1N Range 102W Meridian 6th
320 feet from South Section line and 573 feet from East Section Line
N or S E or W

The well is located on: Patented land ☐ State land ☐ Federal land ☒

The well is located within a spaced area: Yes ☐ No ☒

Distance from proposed location to nearest property or lease line _____ feet.

Distance from proposed location to nearest drilling unit line _____ feet.

Objectives: Mancos Shale Depth 3500'; _____ Depth _____
Formation Estimate Formation Estimate

Proposed length of surface casing 200' feet.

REMARKS:

Agent	<input checked="" type="checkbox"/>
Bond	<input checked="" type="checkbox"/>
Spot	<u>Plotted 2/20/63</u>
600 ft.	<u>Shale</u>
1200 ft.	
Wells	
Oil	
Gas	
Status	

I/We hereby swear (or affirm) that the statements herein made are a full and correct report.

APPROVED:

Date FEB 20 1963

Company ARROWHEAD OIL COMPANY Date Feb. 18, 1963
1421 West Sherwood Dr.

Address Grand Junction, Colo Phone No. 242-6262

By James H. Cox Title Sec.-Treas.
Signature

Director