



01093259


LOCATION PLAT
FOR
ROSEN NO. 2 WELL

RECEIVED
JUN 10 1966
OIL & GAS
CONSERVATION COMMISSION

SW. NW. SE., SEC. 11, T.1N., R.102 W., 6 th. Prin. Base & MER.

RIO BLANCO COUNTY, COLO.

ELEV. GRD. - 5435'

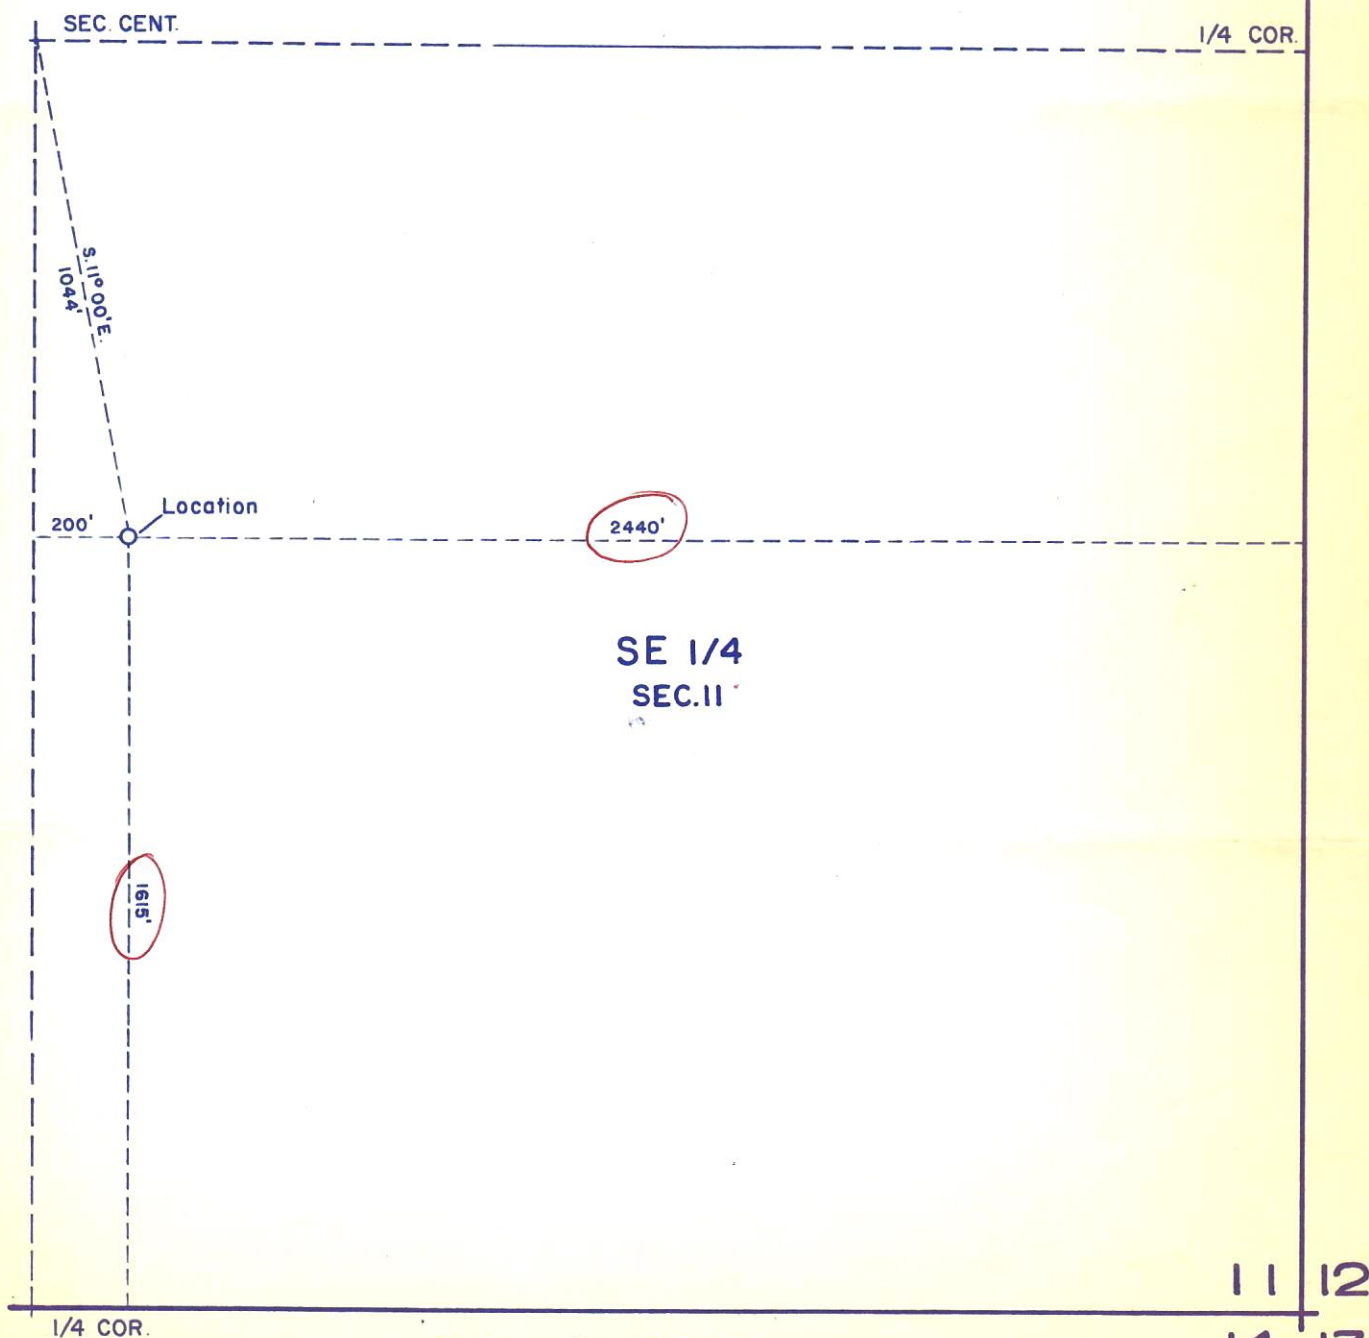

66 204

Scale : 1" = 400 feet
Date : June 2, 1966
Surveyed By : W. Don Quigley