P&A Wellbore For State

Well Name: REINICK C09-22

Land, Original Hole, 9/19/2023 8:12:48 AM

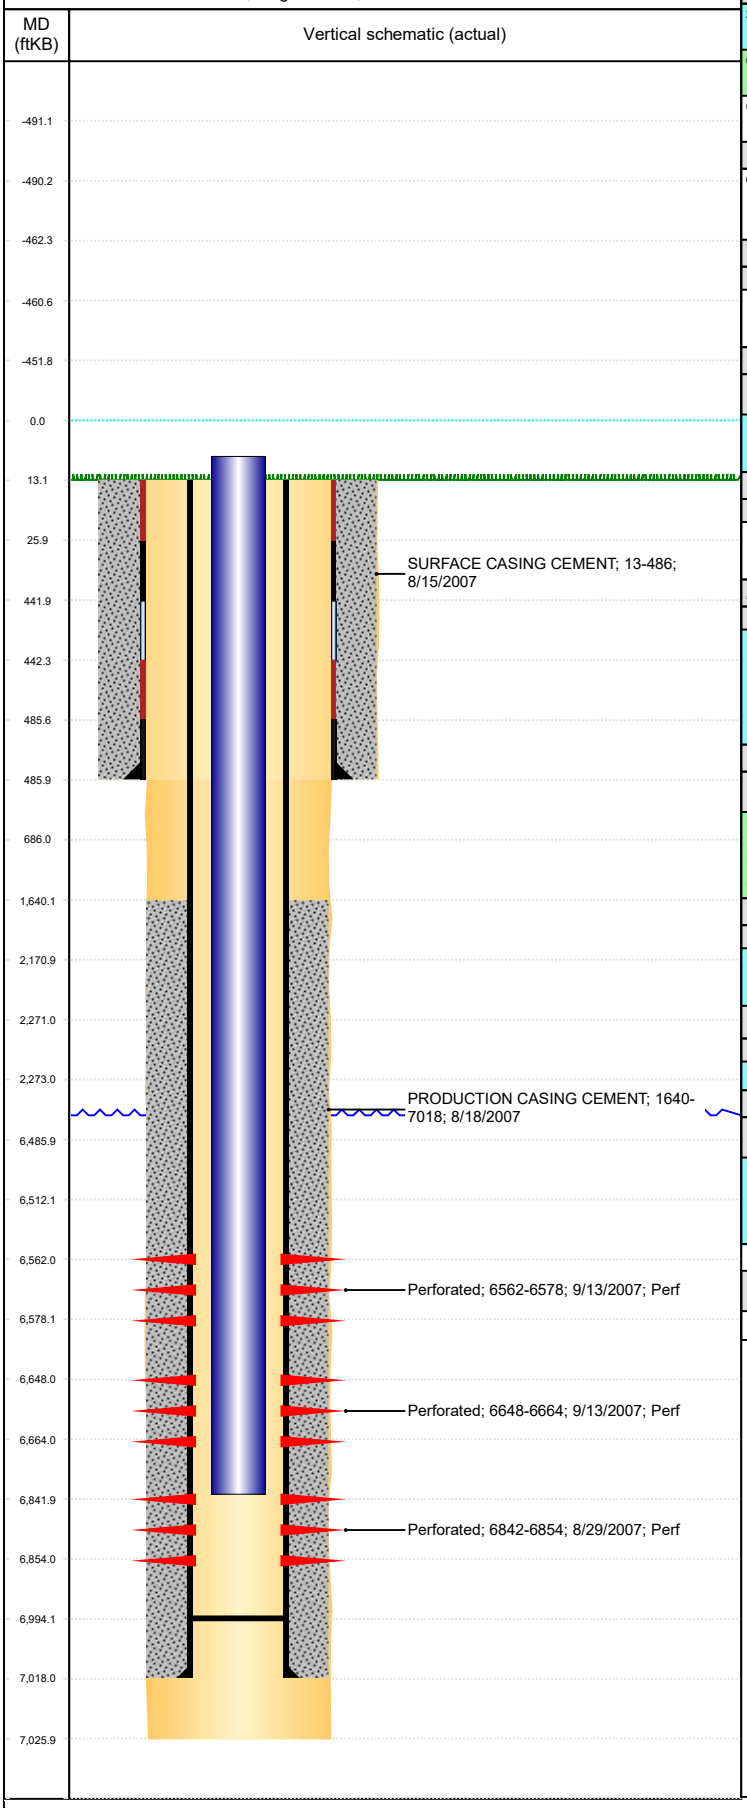

Well Header

Surface UWI	Business Unit	Gov Auth Dist	Prod Tree Loc
0512326159	Rockies		Land

Orig. KB to Gnd (ft)	Original Spud Date	Abandon Date	Well Sub-Status	High…
13.00	8/15/2007		PR	N

Comment

Surface Location (Congressional)

Qtr 3	Qtr 4	Section	Twnshp	Twnsh…	Range	Rng E/…	Latitude (°)	Longitude (°)
SE	NE	9	4	N	64	W	40.327160807	-104.550813414

Wellbore Sections

Section Des	Hole Size (in)	Act Top (ftKB)	Act Btm (ftKB)
SURFACE	12 1/4	13.0	486.0
PRODUCTION	7 7/8	486.0	7,026.0

Casing Strings

Csg Des	Run Date	OD (in)	Wt/Len (lb/ft)	Grade	Top Depth (MD) (ftKB)	Set Depth (MD) (ftKB)
Surface	8/15/2007	8 5/8	24.00	J-55	13	486
Production Casing	8/18/2007	4 1/2	11.60	M-80	13	7018

Cement

Des	Start Date	Top (ftKB)	Btm (ftKB)
SURFACE CASING CEMENT	8/15/2007	13.0	486.0
PRODUCTION CASING CEMENT	8/18/2007	1,640.0	7,018.0

Zone Statuses

Zone Name	Status Date	Status	Fluid Type	Job	Prod Method
NIOBRARA	10/24/2007	PR		DRILLING/COMPLETION - ORIGINAL, 8/15/2007…	
NIOBRARA	4/23/2010	PR			Flowing
CODELL	4/23/2010	PR			Flowing
CODELL	2/26/2018	PR			

Perforation Data

Linked Zone	Explosive Type	Entered Shot Total	Top (ftKB)	Btm (ftKB)	Date
NIOBRARA, Original Hole		64	6,562.0	6,578.0	9/13/2007
NIOBRARA, Original Hole		64	6,648.0	6,664.0	9/13/2007
CODELL, Original Hole		48	6,842.0	6,854.0	8/29/2007

Stimulation Intervals

Zone	Start Date	Top (ftKB)	Btm (ftKB)
NIOBRARA, Original Hole	9/13/2007		
CODELL, Original Hole	9/13/2007		

Other In Hole

Run Date	Des	Make	OD (in)	Top (ftKB)	Btm (ftKB)

Logs

Date	Type	Depth Top (MD) (ftKB)	Btm (ftKB)
8/18/2007	Compensated Density	2,590	7,005.0
8/18/2007	Induction	486	7,025.0
8/28/2007	CBL/CCL/GR	1,500	6,977.0

Plug Back Total Depths

Date	Type	Com	PBTD (ftKB)
8/18/2007	FLOAT SHOE		6,994