




00063821

RECEIVED

JUL - 9 1969

COLO. OIL & GAS CONS. COMM.

M U SMITH - 052318

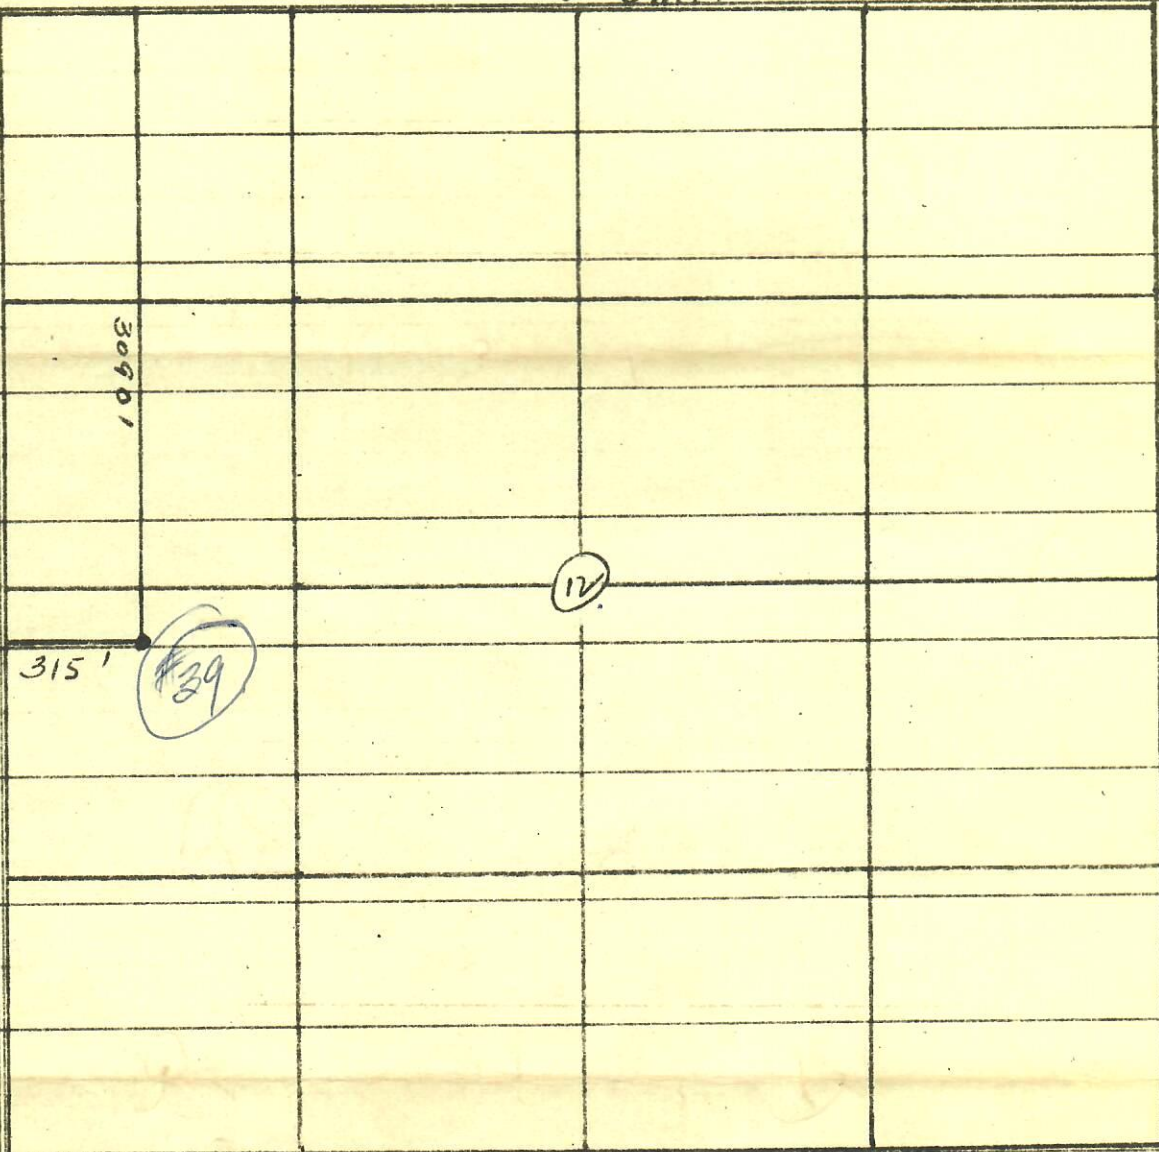

NW 1/4 OF SW 1/2 R 102 W
SEC 14