


OIL AND GAS COMMISSION OF THE STATE OF COLORADO

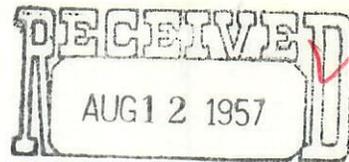

NOTICE OF INTENTION TO DRILL

OIL & GAS CONSERVATION COMMISSION


INSTRUCTIONS:

A notice of intention to drill a well shall be filed in duplicate on all Federal and Patented lands, and in triplicate on all State lands. Do not begin operations until approved copy has been received. It is mandatory that the proposed location comply with all rules and regulations of the Commission. Locate well on section grid in proper location, and indicate extent of lease. Unless operations are commenced within 180 days after the date of approval hereof, this approval to drill will become null and void.

Name of Operator Rangely Oil and Gas Company Phone No. 641
Address Box 26 City Rangely State Colorado

How is liability secured: Well Bond (Attached) [ ]; Blanket Bond [ ]; Waiver [X] (Check one)

Lease Name GeBauer-Jones 032682
Well No. 10
Field Name Rangely Wildcat [ ]
County Rio Blanco

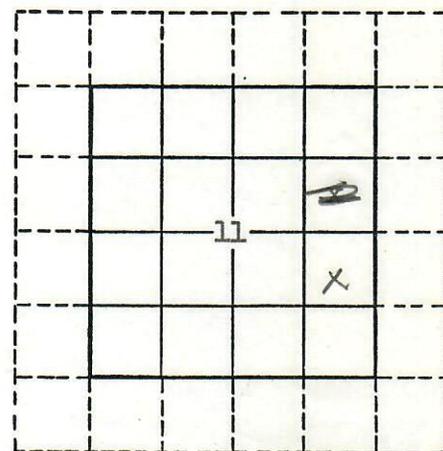

Location NE 1/4 of SE 1/4 Section 11 Township 1N Range 102W Meridian 6
2215 feet from S Section line and 800 feet from E Section Line
N or S E or W

The well is located on: Patented land [ ] State land [ ] Federal land [X]

The well is located within a spaced area: Yes [ ] No [X]

Distance from proposed location to nearest property or lease line 800 feet.
Distance from proposed location to nearest drilling unit line [ ] feet.

Objectives: Mancos Shale Depth 3000; Formation Estimate; Formation Estimate

Proposed length of surface casing 20 feet.

Table with 2 columns and 8 rows: AJJ, DVR, FJK, WRS, HHA, AH, JJD, FILE

REMARKS:

It is our intent to drill a well to test for oil in the Mancos Shale above the Dakota horizon.

I/We hereby swear (or affirm) that the statements herein made are a full and correct report.

APPROVED: Date AUG 12 1957

Company Rangely Oil and Gas Co. Date 8-9-57

Address Box 26, Rangely, Colo. Phone No. 641

By Bill L. Jacobs Title Vice-President Signature

Signature of Director

Signature of Bill L. Jacobs

