




OIL AND GAS CONSERVATION COMMISSION OF THE STATE OF COLORADO

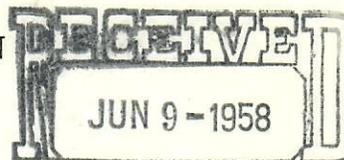

NOTICE OF INTENTION TO DRILL

OIL & GAS CONSERVATION COMMISSION


INSTRUCTIONS:

A notice of intention to drill a well shall be filed in duplicate on all Federal and Patented lands, and in triplicate on all State lands. Do not begin operations until approved copy has been received. It is mandatory that the proposed location comply with all rules and regulations of the Commission. Locate well on section grid in proper location, and indicate extent of lease. Unless operations are commenced within 180 days after the date of approval hereof, this approval to drill will become null and void.

Name of Operator Knapp Uranium Development Company Phone No. AM 6-3218
Address 555 East 5600 South City Salt Lake City State Utah

How is liability secured: Well Bond (Attached) []; Blanket Bond []; Waiver [X] Application approved (Check one)

Lease Name Harper Block (Nichols lease)
Well No. 2
Field Name None Wildcat [X]
County Mesa

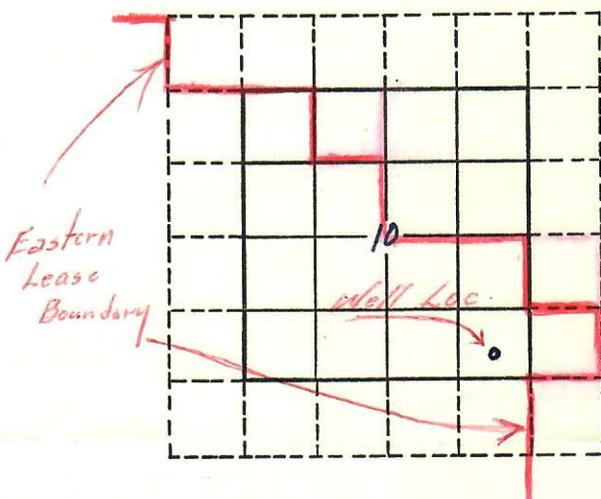

Location SE SE Section 10 Township 2 North Range 3 West Meridian Ute
288 feet from South Section line and 453 feet from East Section Line
N or S E or W

The well is located on: Patented land [X] State land [] Federal land []

The well is located within a spaced area: Yes [] No [X]

Distance from proposed location to nearest property or lease line 288 feet.
Distance from proposed location to nearest drilling unit line Unknown feet.

Objectives: Dakota Formation Depth 1550 feet Estimate; Entrada Formation Depth 2350 Estimate

Proposed length of surface casing 100 feet.

Table with columns for Agent, Bond, Spot, 600 ft., 1200 ft., Wells, Oil, Gas, Status. Includes handwritten notes like 'Waived', 'Valid OK', 'attached', 'D/S'.

REMARKS: Intentions are to deepen a cable tool hole drilled in 1949 to approximately 1500 feet. This hole was originally drilled as a water well but was never completed as such.

Attached is a waiver, signed by the patentee and/or lessor, consenting to the reentering of this hole.

Verbal approval received from A. J. Jersin by long distance telephone call at 2:45 P.M. June 6, 1958.

I/We hereby swear (or affirm) that the statements herein made are a full and correct report.

APPROVED:

Date JUN - 9 1958

Signature of A. J. Jersin, Director

Company Knapp Uranium Dev. Company Date June 6, 1958

Address 555 East 5600 South Salt Lake City, Utah Phone No. AM 6-3218

By Max Krey Signature Title Geologist