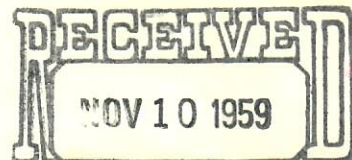


OIL AND GAS COMMISSION
OF THE STATE OF COLORADOOIL & GAS
CONSERVATION COMMISSION

NOTICE OF INTENTION TO DRILL


INSTRUCTIONS:

A notice of intention to drill a well shall be filed in duplicate on all Federal and Patented lands, and in triplicate on all State lands. Do not begin operations until approved copy has been received. It is mandatory that the proposed location comply with all rules and regulations of the Commission. Locate well on section grid in proper location, and indicate extent of lease. Unless operations are commenced within 180 days after the date of approval hereof, this approval to drill will become null and void.

Name of Operator Ralph Bradley Phone No. CHapel 2-8292
Address Box 1195 City Grand Junction State Colorado

How is liability secured: Well Bond (Attached) ☒; Blanket Bond ☐; Waiver ☐
(Check one)

Lease Name Highline Community Unit (Reynolds)
Well No. Globe No. 2 Reynolds
Field Name Highline Community Wildcat ☒
County Mesa

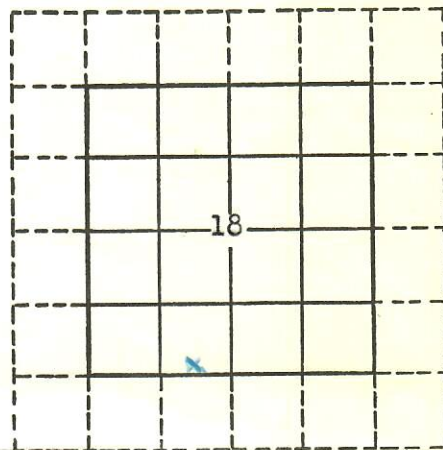

Location SE SW Section 18 Township 2N Range 2W Meridian UPM
(quarter quarter)
155 feet from South Section line and 1900 feet from West Section Line
N or S E or W

The well is located on: Patented land ☒ State land ☐ Federal land ☐

The well is located within a spaced area: Yes ☐ No ☒

Distance from proposed location to nearest property or lease line 3380 feet.

Distance from proposed location to nearest drilling unit line 3380 feet.

Objectives: Dakota Depth ; Morrison Depth 2200
Formation Estimate Formation Estimate

Proposed length of surface casing 250' feet.

REMARKS:

Test for gas.

Agent	<u>BA</u>
Bond	<u>Attached</u>
Spot	
600 ft.	
1200 ft.	
Wells	
Oil	
Gas	
Status	

I/We hereby swear (or affirm) that the statements herein made are a full and correct report.

APPROVED:

Date NOV 12 1959

Company Globe Oil & Gas Co. Date Nov. 9, 1959

Address Box 1195 Phone No. CH 2-8292

By Ralph R. Bradley Title President
Signature

Director