


Timbro 0112-02H

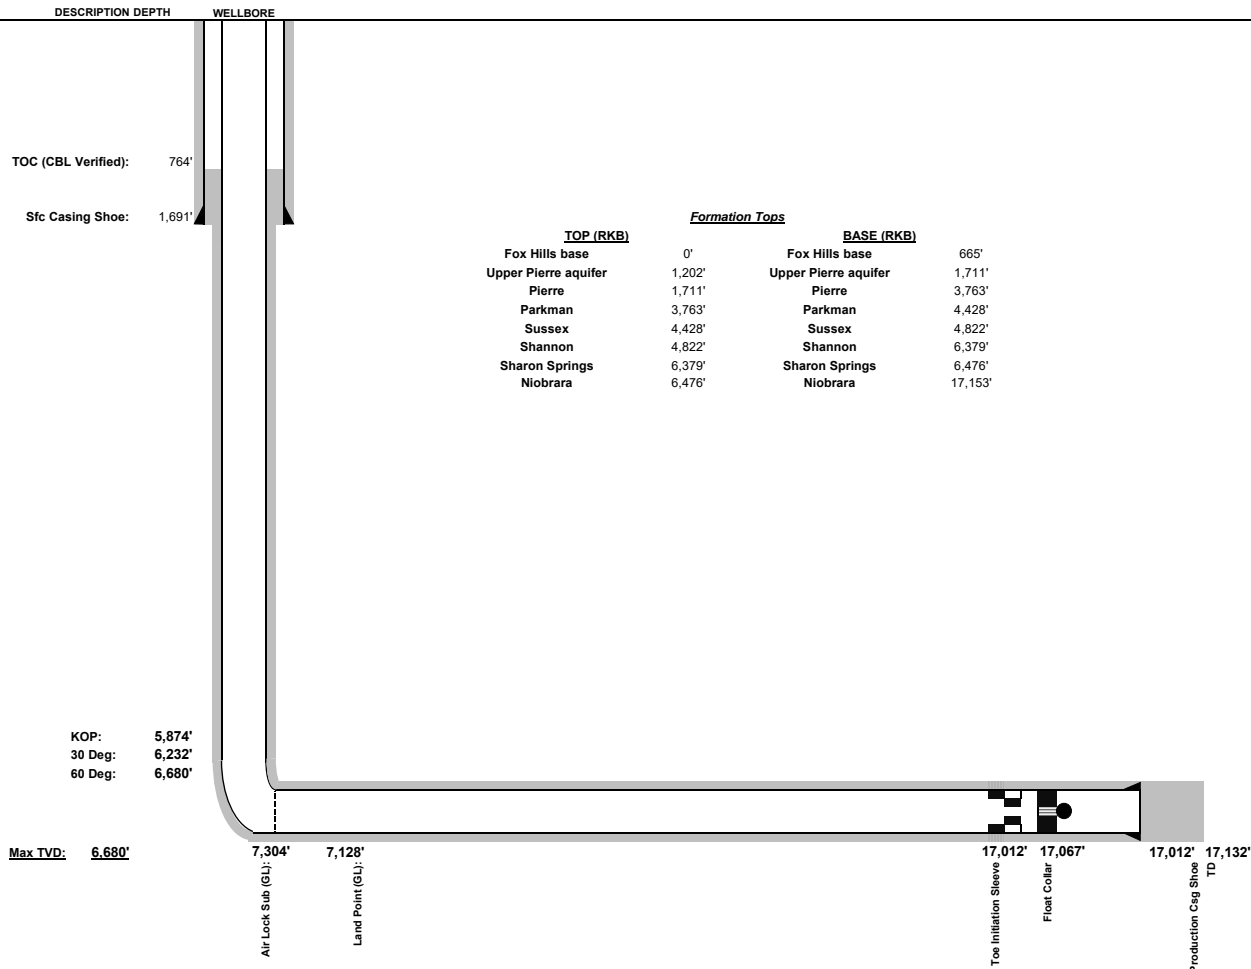

		Date		9/25/2023		
WELL:	Timbro 0112-02H	Pre-Frac WBD				
LOCATION:	Lot 2 Sec 1 09N59W					
FORMATION:	Nio C Chalk					
API #:	05-123-51083					
Field:	DJ Horizontal Niobrara					
Spud:	07/28/23					
Current Status:	Awaiting Completions					
Well Type	Horizontal					
Well Length	XRL					
Casing and Tubular Data						
Type	Size	Weight	Top	Bottom	Hole Size	Cement Type
Surface	9 5/8	36.0 ppf	0'	1,691'	13.5"	Class G
Production	5 1/2	20.0 ppf	0'	17,117'	8-3/4"	13.2 Lead, 13.2 Tail
Tubing	2 3/8	4.6 ppf	0'	n/a	n/a	N/A
Elevation Data						
GL	4939	feet				
KB	4960	feet				
Difference	21	feet				
*All depths from GL unless otherwise noted						
TPZ/ Heal Setback Depth (MD GL): 7,021'						
BPZ/ Toe Setback Depth (MD GL): 17,033'						
Production Casing Info: 5.5" 20# US Steel P110HP Freedom HTQ						
Cement to Surface during 5.5" Job: 44 bbls						