


Timbro 0112-05H

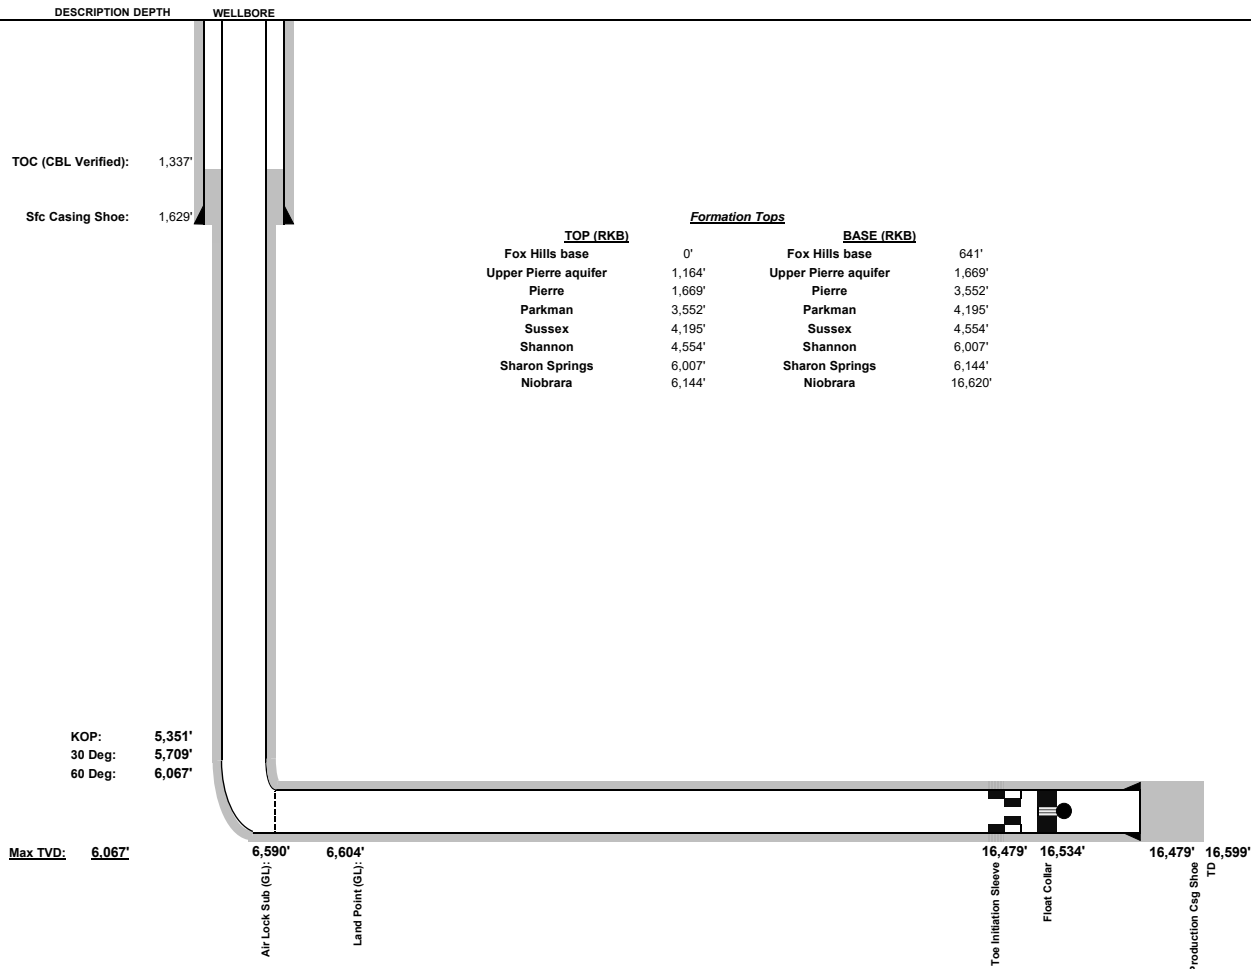

Date			9/25/2023
WELL:	Timbro 0112-05H	Pre-Frac WBD	
LOCATION:	Lot 2 Sec 1 09N59W		
FORMATION:	Nio B Marl		
API #:	05-123-51082		
Field:	DJ Horizontal Niobrara		
Spud:	07/15/23		
Current Status:	Awaiting Completions		
Well Type	Horizontal		
Well Length	XRL		
Casing and Tubular Data			
Type	Size	Weight	Top Bottom Hole Size Cement Type
Surface	9 5/8	36.0 ppf	0' 1,629' 13.5" Class G
Production	5 1/2	20.0 ppf	0' 16,584' 8-3/4" 13.2 Lead, 13.2 Tail
Tubing	2 3/8	4.6 ppf	0' n/a n/a N/A
Elevation Data			
GL	4939	feet	
KB	4960	feet	
Difference	21	feet	
*All depths from GL unless otherwise noted			
TPZ/ Heal Setback Depth (MD GL): 6,466'			
BPZ/ Toe Setback Depth (MD GL): 16,493'			
Production Casing Info: 5.5" 20# US Steel P110HP Freedom HTQ			
Cement to Surface during 5.5" Job: 56 bbls			