


Timbro 0112-03H

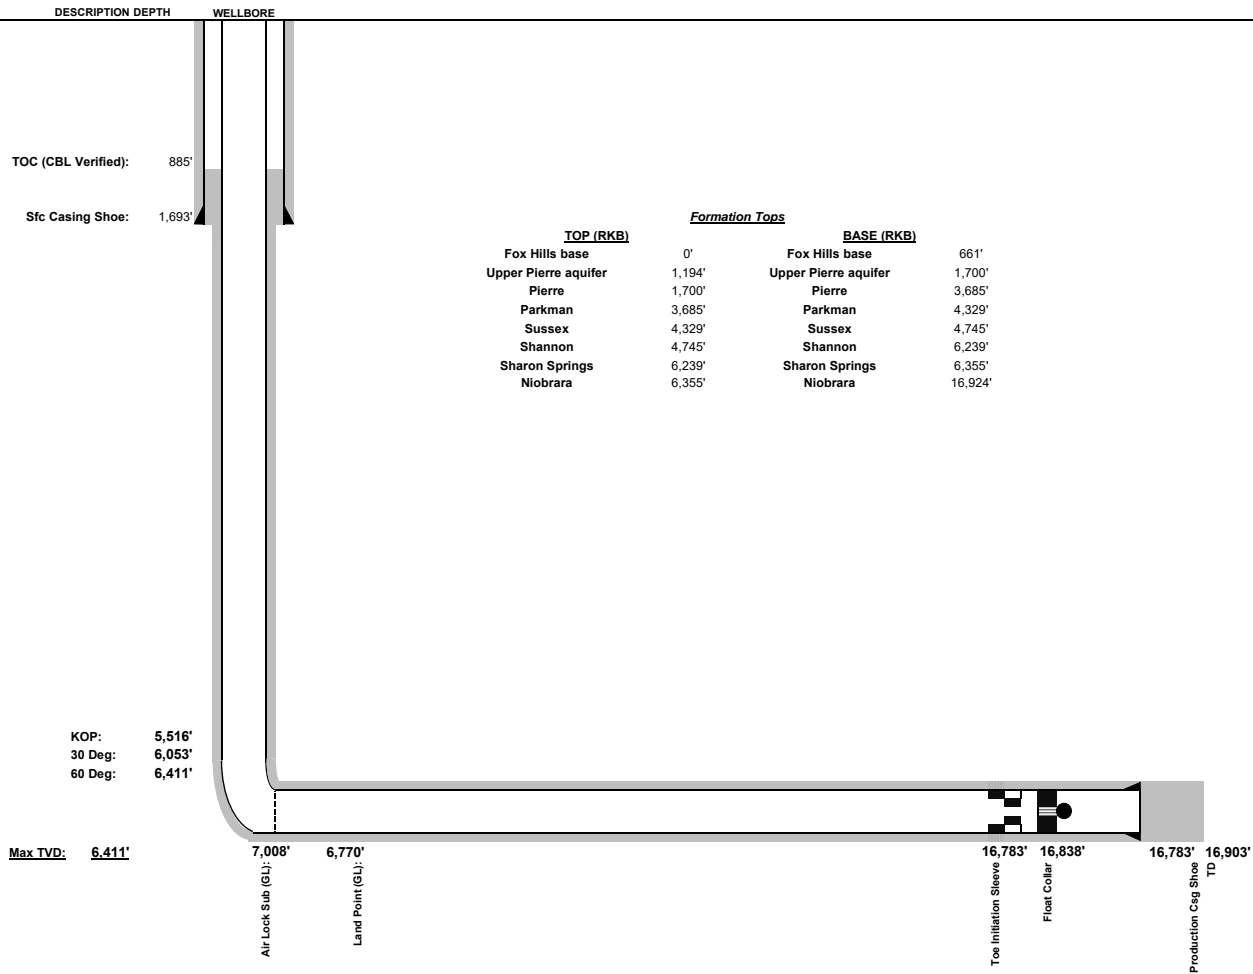

Date 9/25/2023

WELL: Timbro 0112-03H Pre-Frac WBD

LOCATION: Lot 2 Sec 1 09N59W

FORMATION: Nio B Marl

API #: 05-123-51087

Field: DJ Horizontal Niobrara

Spud: 07/24/23

Current Status: Awaiting Completions

Well Type Horizontal

Well Length XRL

Casing and Tubular Data

Type	Size	Weight	Top	Bottom	Hole Size	Cement Type
Surface	9 5/8	36.0 ppf	0'	1,693'	13.5"	Class G
Production	5 1/2	20.0 ppf	0'	16,888'	8-3/4"	13.2 Lead, 13.2 Tail
Tubing	2 3/8	4.6 ppf	0'	n/a	n/a	N/A

Elevation Data

GL	4939	feet
KB	4960	feet
Difference	21	feet
*All depths from GL unless otherwise noted		

TPZ/ Heal Setback Depth (MD GL): 6,771'

BPZ/ Toe Setback Depth (MD GL): 16,791'

Production Casing Info: 5.5" 20# US Steel P110HP Freedom HTQ

Cement to Surface during 5.5" Job: 50 bbls