




# P&A Wellbore For State

Well Name: KREPS 06-35

Land, Original Hole, 10/3/2023 1:18:50 PM

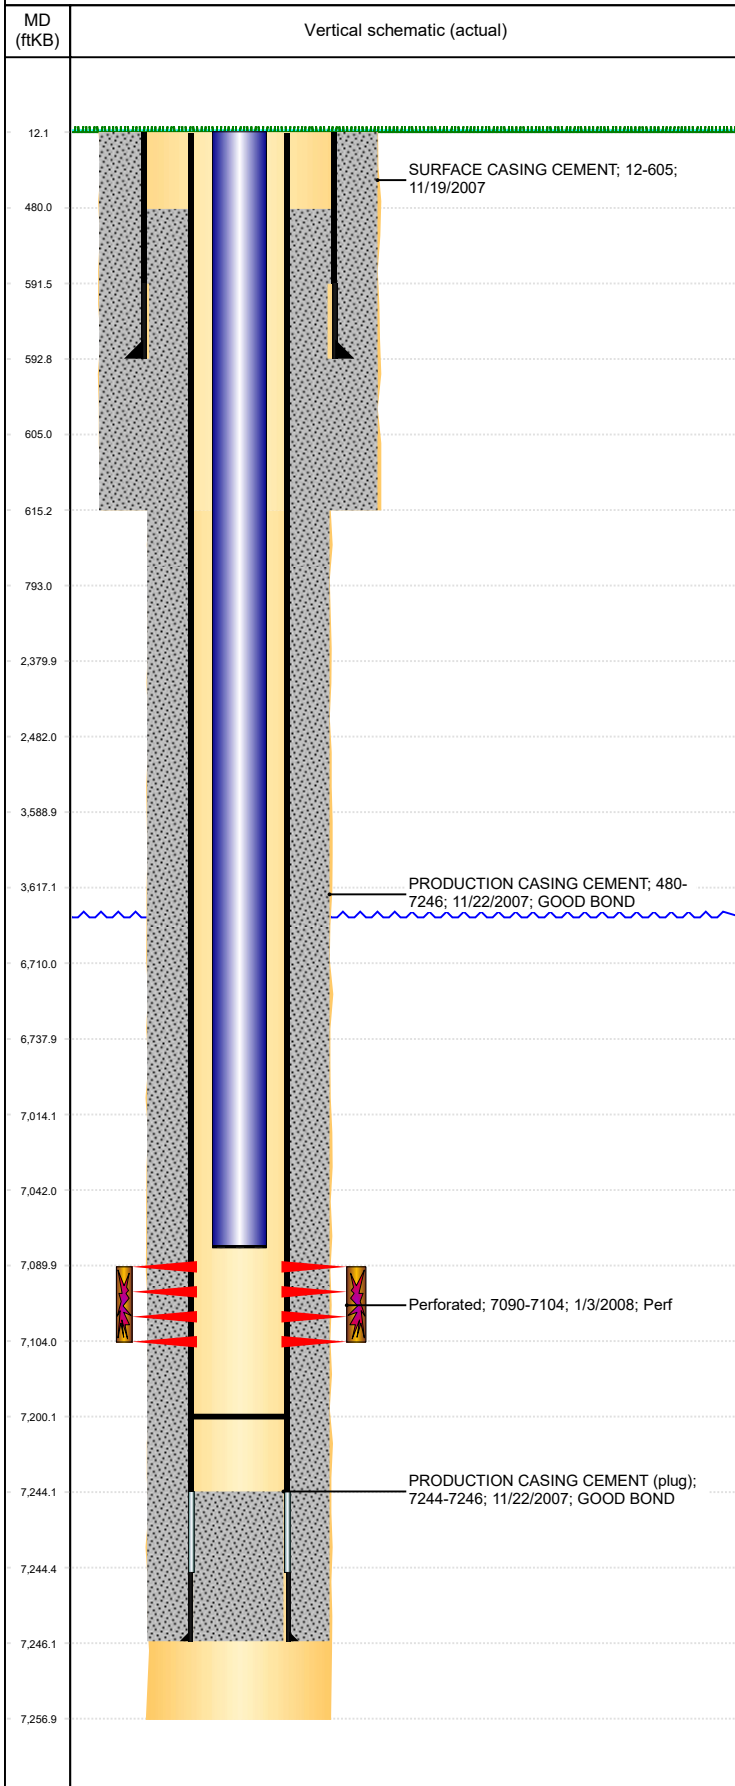

## Well Header

|                               |                                  |               |                       |
|-------------------------------|----------------------------------|---------------|-----------------------|
| Surface UWI<br>0512324937     | Business Unit<br>Rockies         | Gov Auth Dist | Prod Tree Loc<br>Land |
| Orig. KB to Gnd (ft)<br>12.00 | Original Spud Date<br>11/17/2007 | Abandon Date  | Well Sub-Status<br>PR |
| High...<br>N                  |                                  |               |                       |
| Comment                       |                                  |               |                       |

## Surface Location (Congressional)

|             |             |              |             |               |             |               |                                      |                             |
|-------------|-------------|--------------|-------------|---------------|-------------|---------------|--------------------------------------|-----------------------------|
| Qtr 3<br>SW | Qtr 4<br>SW | Section<br>6 | Twnshp<br>6 | Twnsh...<br>N | Range<br>64 | Rng E...<br>W | Latitude (°)<br>40.51115999<br>99999 | Longitude (°)<br>-104.59766 |
|-------------|-------------|--------------|-------------|---------------|-------------|---------------|--------------------------------------|-----------------------------|

## Wellbore Sections

| Section Des | Hole Size (in) | Act Top (ftKB) | Act Btm (ftKB) |
|-------------|----------------|----------------|----------------|
| SURFACE     | 12 1/4         | 12.0           | 615.0          |
| PRODUCTION  | 7 7/8          | 615.0          | 7,257.0        |

## Casing Strings

| Csg Des           | Run Date   | OD (in) | Wt/Len (lb/ft) | Grade | Top Depth (MD) (ftKB) | Set Depth (MD) (ftKB) |
|-------------------|------------|---------|----------------|-------|-----------------------|-----------------------|
| Surface           | 11/18/2007 | 8 5/8   | 24.00          |       | 12                    | 593                   |
| Production Casing | 11/21/2007 | 4 1/2   | 11.60          | M-80  | 12                    | 7246                  |

## Cement

| Des                      | Start Date | Top (ftKB) | Btm (ftKB) |
|--------------------------|------------|------------|------------|
| SURFACE CASING CEMENT    | 11/19/2007 | 12.0       | 605.0      |
| PRODUCTION CASING CEMENT | 11/22/2007 | 480.0      | 7,246.0    |

## Zone Statuses

| Zone Name | Status Date | Status | Fluid Type | Job | Prod Method |
|-----------|-------------|--------|------------|-----|-------------|
| CODELL    | 4/14/2010   | PR     | Water      |     | Flowing     |
| CODELL    | 9/11/2017   | PR     |            |     |             |

## Perforation Data

| Linked Zone           | Explosive Type | Entered Shot Total | Top (ftKB) | Btm (ftKB) | Date     |
|-----------------------|----------------|--------------------|------------|------------|----------|
| CODELL, Original Hole |                | 56                 | 7,090.0    | 7,104.0    | 1/3/2008 |

## Stimulation Intervals

| Zone                  | Start Date | Top (ftKB) | Btm (ftKB) |
|-----------------------|------------|------------|------------|
| CODELL, Original Hole | 1/4/2008   | 7,090.0    | 7,104.0    |

## Other In Hole

| Run Date | Des | Make | OD (in) | Top (ftKB) | Btm (ftKB) |
|----------|-----|------|---------|------------|------------|
|          |     |      |         |            |            |

## Logs

| Date       | Type                | Depth Top (MD) (ftKB) | Btm (ftKB) |
|------------|---------------------|-----------------------|------------|
| 11/21/2007 | COMPENSATED DENSITY | 3,290                 | 7,224.0    |
| 11/21/2007 | INDUCTION           | 605                   | 7,224.0    |
| 12/28/2007 | CBL/CCL/GR          | 300                   | 7,228.0    |

## Plug Back Total Depths

| Date       | Type | Com              | PBTD (ftKB) |
|------------|------|------------------|-------------|
| 12/28/2007 | FILL | CBL DEPTH LOGGER | 7,230       |
| 2/7/2008   | FILL | MOST RECENT C/O  | 7,200       |