Schematic - Actual

Well Name: Ruff 22-3 **TD: 7,257.0**

API	Surface Legal Location	Field Name	State
05123231070000	SENW 3 6N 64W	Wattenberg	CO
Well Configuration Type	**Ground Elevation (ft)**	**Original KB Elevation (ft)**	**KB-Ground Distance (ft)**
Vertical	4,810.00	4,820.00	10.00

Most Recent Job

Job Category	Primary Job Type	Secondary Job Type	Start Date	End Date
Other	Wireline		8/22/2019	8/22/2019
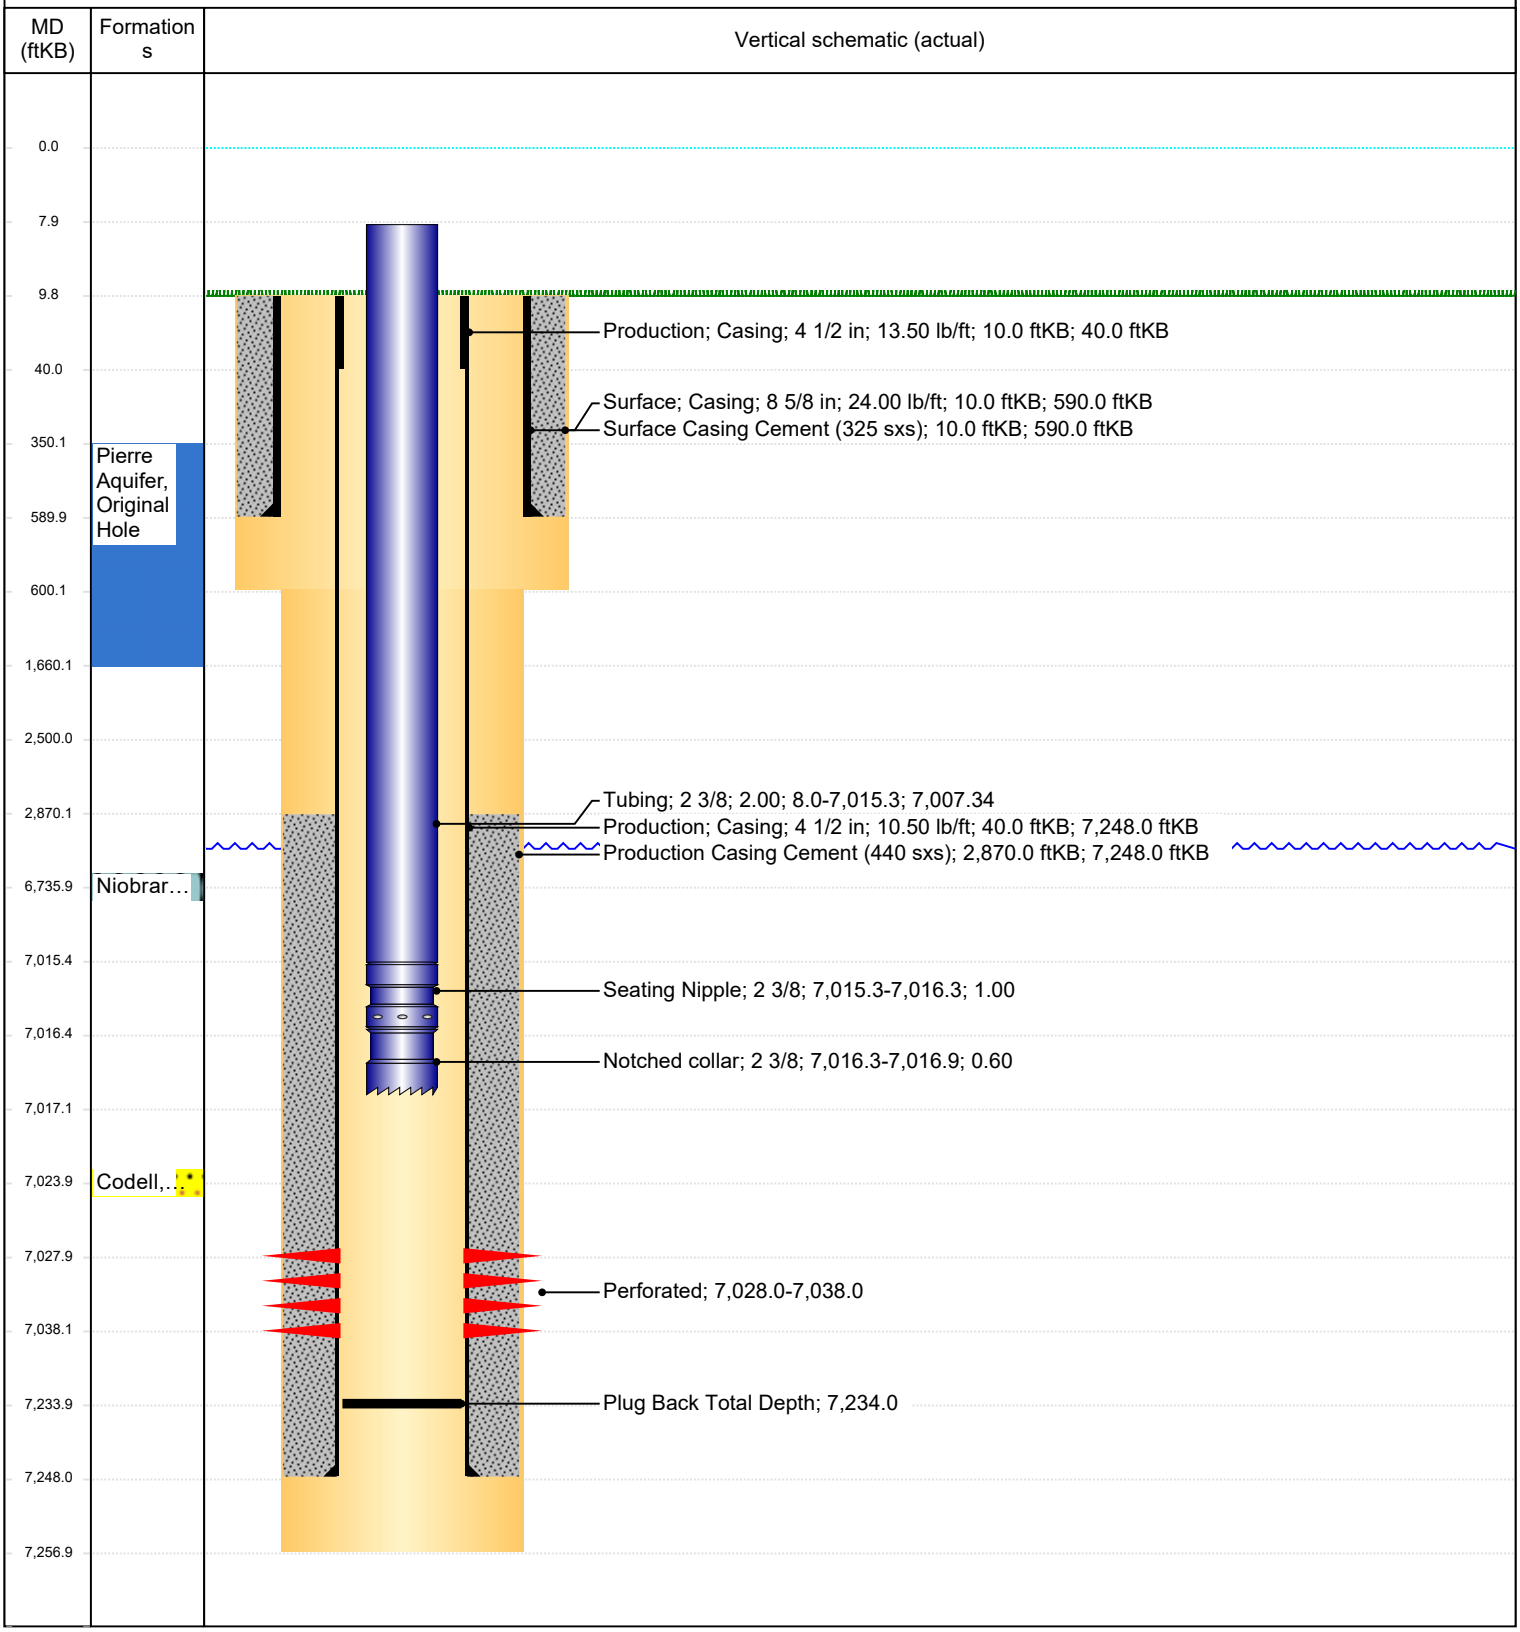
Vertical, Original Hole, 10/2/2023 4:42:18 PM