




# P&A Wellbore For State

Well Name: STEPHENSON 6-33

Land, Original Hole, 10/5/2023 2:01:27 PM

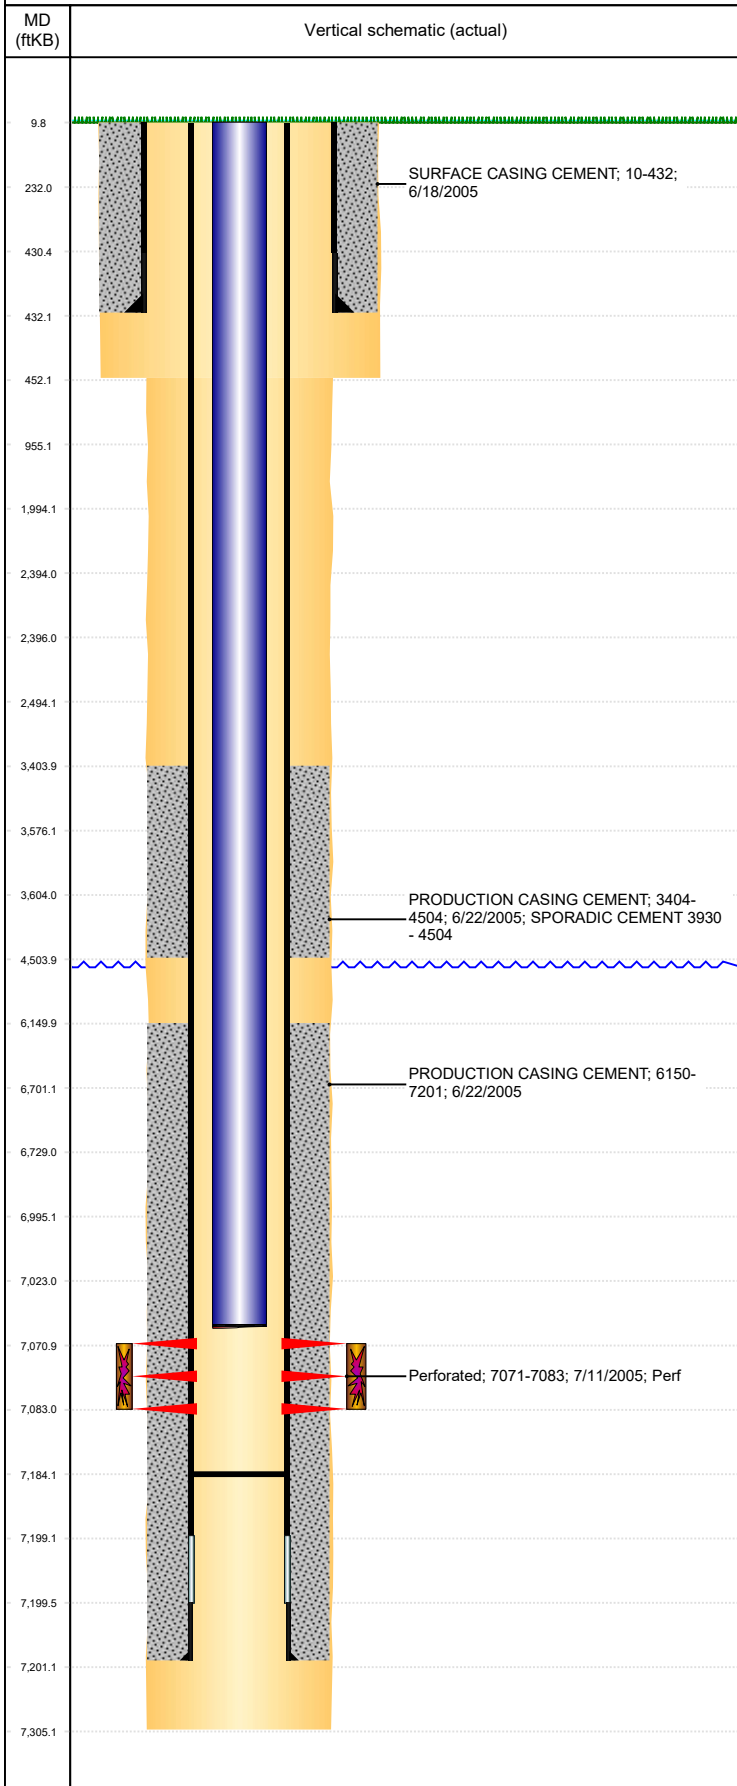

## Well Header

|                               |                                 |               |                       |
|-------------------------------|---------------------------------|---------------|-----------------------|
| Surface UWI<br>0512322623     | Business Unit<br>Rockies        | Gov Auth Dist | Prod Tree Loc<br>Land |
| Orig. KB to Gnd (ft)<br>10.00 | Original Spud Date<br>6/16/2005 | Abandon Date  | Well Sub-Status<br>PR |
| Comment                       |                                 |               |                       |

## Surface Location (Congressional)

|             |             |              |              |                |             |                |                          |                             |
|-------------|-------------|--------------|--------------|----------------|-------------|----------------|--------------------------|-----------------------------|
| Qtr 3<br>SW | Qtr 4<br>SW | Section<br>6 | Twonshp<br>6 | Twonsh...<br>N | Range<br>64 | Rng E/...<br>W | Latitude (°)<br>40.50991 | Longitude (°)<br>-104.59974 |
|-------------|-------------|--------------|--------------|----------------|-------------|----------------|--------------------------|-----------------------------|

## Wellbore Sections

| Section Des | Hole Size (in) | Act Top (ftKB) | Act Btm (ftKB) |
|-------------|----------------|----------------|----------------|
| SURFACE     | 12 1/4         | 10.0           | 452.0          |
| PRODUCTION  | 7 7/8          | 452.0          | 7,305.0        |

## Casing Strings

| Csg Des           | Run Date  | OD (in) | Wt/Len (lb/ft) | Grade | Top Depth (MD) (ftKB) | Set Depth (MD) (ftKB) |
|-------------------|-----------|---------|----------------|-------|-----------------------|-----------------------|
| Surface           | 6/17/2005 | 8 5/8   | 24.00          |       | 10                    | 432                   |
| Production Casing | 6/22/2005 | 4 1/2   | 11.60          | I-80  | 10                    | 7201                  |

## Cement

| Des                      | Start Date | Top (ftKB) | Btm (ftKB) |
|--------------------------|------------|------------|------------|
| SURFACE CASING CEMENT    | 6/18/2005  | 10.0       | 432.0      |
| PRODUCTION CASING CEMENT | 6/22/2005  | 3,404.0    | 4,504.0    |
| PRODUCTION CASING CEMENT | 6/22/2005  | 6,150.0    | 7,201.0    |

## Zone Statuses

| Zone Name | Status Date | Status | Fluid Type | Job | Prod Method |
|-----------|-------------|--------|------------|-----|-------------|
| CODELL    | 9/19/2011   | PR     | Water      |     | Flowing     |
| CODELL    | 9/11/2017   | PR     |            |     |             |

## Perforation Data

| Linked Zone           | Explosive Type | Entered Shot Total | Top (ftKB) | Btm (ftKB) | Date      |
|-----------------------|----------------|--------------------|------------|------------|-----------|
| CODELL, Original Hole |                | 48                 | 7,071.0    | 7,083.0    | 7/11/2005 |

## Stimulation Intervals

| Zone                  | Start Date | Top (ftKB) | Btm (ftKB) |
|-----------------------|------------|------------|------------|
| CODELL, Original Hole | 7/14/2005  | 7,071.0    | 7,083.0    |

## Other In Hole

| Run Date | Des | Make | OD (in) | Top (ftKB) | Btm (ftKB) |
|----------|-----|------|---------|------------|------------|
|          |     |      |         |            |            |

## Logs

| Date      | Type                | Depth Top (MD) (ftKB) | Btm (ftKB) |
|-----------|---------------------|-----------------------|------------|
| 6/21/2005 | COMPENSATED DENSITY | 3,600                 | 7,194.0    |
| 6/21/2005 | INDUCTION           | 452                   | 7,214.0    |
| 7/11/2005 | CEMENT BOND         | 3,000                 | 7,177.0    |

## Plug Back Total Depths

| Date      | Type | Com                 | PBTD (ftKB) |
|-----------|------|---------------------|-------------|
| 7/11/2005 | FILL | DEPTH LOGGER ON CBL | 7,179       |
| 2/23/2006 | FILL | TAG TO LAND TUBING  | 7,184       |